

HANCOCK

MISSISSIPPI BOARD OF WATER COMMISSIONERS

K 169
B-3-65

WATER WELL DRILLERS LOG

^{Mark}
CODED

Date: 8-3, 1965, Driller: Water Well Works ^{Mark} County Hancock
(Name)

(1) Owner of Land: E. R. Nance
(Name)

Rt 1 Box 457 A-1; Bay St Louis
(Address) Miss

(2) Location: NE 1/4, NE 1/4, Sec. 40 T8S R14 W
6 miles W of Bay St Louis
(distance) (direction) (Nearest Town)

(3) Topography: flat
(Hilly) (Flat) (Level)

(4) Purpose of Well: domestic
(Domestic Irrigation
Municipal, Industrial, Other)

Description & Color of Materials Sand, Clay, Red Clay, Shell, etc.	Thick- ness Feet	Depth Feet
<u>Clay</u>	<u>10</u>	<u>10</u>
<u>Sand</u>	<u>28</u>	<u>38</u>
<u>Clay</u>	<u>48</u>	<u>86</u>
<u>Clay - sand streaks</u>		<u>157</u>
<u>Sand</u>	<u>15</u>	<u>172</u>

Information upon completion of well:


- (1) Diameter 2 inches.
- (2) Total Depth 172 feet.
- (3) Water Level 1 feet below top of ground.
- (4) Cased to all, Size 2".
- (5) Screen: Size 2", Length 5'.
- (6) Were any formations sealed against pollution?
 yes, no.

CODED

If YES depth of formation _____

Why _____

Drillers Remarks: _____

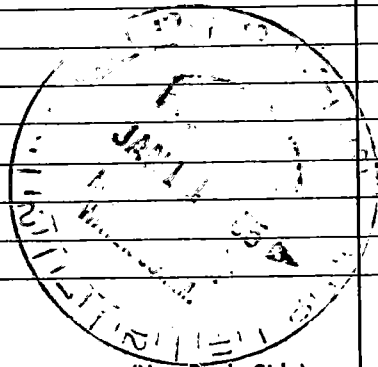

(Use Back Side)

Well No.

