

HANCOCK  
K174  
3-31-61

MISSISSIPPI BOARD OF WATER COMMISSIONERS

WATER WELL DRILLERS LOG

K-334  
**CODED**

Date: 3-31, 1961, Driller: Sutter Well Works County Howards  
(Name)

(1) Owner of Land:	Description & Color of Materials Sand, Clay, Red Clay, Shell, etc.	Thick- ness Feet	Depth Feet
<u>Cleiborne Ledner</u> (Name) <u>Bay St. Louis, Miss.</u> (Address)	<u>surface clay</u>	<u>10</u>	<u>10</u>
(2) Location: <u>1/4</u> , <u>1/4</u> , Sec. <u>42</u> T <u>8</u> R <u>14</u>	<u>sand &amp; gravel</u>	<u>170</u>	<u>180</u>
<u>3</u> miles <u>NW</u> of <u>Bay</u> (distance) (direction) (Nearest town)	<u>clay</u>	<u>332</u>	<u>512</u>
(3) Topography: <u>flat</u> (Hilly) (Flat) (Level)	<u>sand</u>	<u>76</u>	<u>588</u>
(4) Purpose of Well: <u>domestic</u> (Domestic Irrigation Municipal, Industrial, Other)	<u>rock</u>	<u>4</u>	<u>592</u>
	<u>sand</u>	<u>13</u>	<u>605</u>
	<u>clay</u>	<u>351</u>	<u>956</u>
	<u>sand</u>	<u>94</u>	<u>1000</u>


Information upon completion of well:

- (1) Diameter 2 1/2 inches.
- (2) Total Depth 1000 feet.
- (3) Water Level 45 feet above below top of ground.
- (4) Cased to all, Size 2 1/2"
- (5) Screen: Size 2 1/2", Length 20'
- (6) Were any formations sealed against pollution?  
\_\_\_\_\_ yes,  no.

If YES depth of formation \_\_\_\_\_

Why \_\_\_\_\_

Drillers Remarks: \_\_\_\_\_

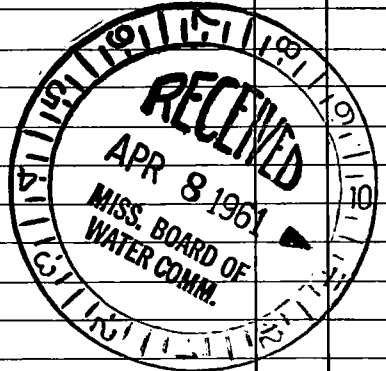

**CODED**

(Use Back Side)

Well No.

