

HANCOCK

~~MISSISSIPPI~~

K186

10-25-71

MISSISSIPPI BOARD OF WATER COMMISSIONERS
416 North State Street
Jackson, Mississippi 39201

CODED

WATER WELL DRILLERS LOG

10-25 1971 J.T. WARD WATER WELLS HANCOCK
date well completed firm name county well located

LANDOWNER: Muriel Hilbert

description of formations encountered

from to

Fourt ave

top soil

0 3

Box St. Louis miss
(mailing address)

Clay

3 16

WELL LOCATION:

sec 8 T 9 N R 14 E
8 miles SW of Box St. Louis
(distance) (direction) (nearest town)

White Sd.

16 30

WELL PURPOSE:
(home, irrigation, municipal, industrial)

WELL COMPLETION DATA:

(1) diameter (inches) 2"

(2) total depth (feet) 923

(3) static water level (feet) flow below top of ground above

(4) casing 2" Adv. 903
(material) (depth)

(size) If telescope see back.

(5) screen 20' -
(length) (depth to top)

2" Stainless Steel
(size) (material)

(6) pump N/A -
(HP) (yield gpm)

(type power)

(7) electric log NO
(yes or no)

N/A
(organization running log)

(8) how well bottom plugged B.W.V.

White Clay

30 65

Sandy Clay

65 88

White Clay

88 96

Sd.

96 135

Riv. gravel

135 155

Blue clay

163 176

SAND-Riv. gravel

176 195

Blue clay

195 225

Sd.

225 303

Sd.-Riv. gravel

303 315

Blue Clay

315 480

Sd.

480 491

Clay

491 530

Clay

530 572

Sd.

572 600

Clay

600 620

Sd.

620 632

Clay

632 685

Sd.

685 690

Clay

690 736

Sd.

736 766

Clay

766 786

Sd.

786 809

Clay

809 820

Sd.

820 873

Clay

873 923

CODED

NOV 12 1971


DRILLERS REMARKS:

See back.

MISS. BD. OF
WATER COMM.

If well telescopes please sketch and show depths.

GROUND LEVEL

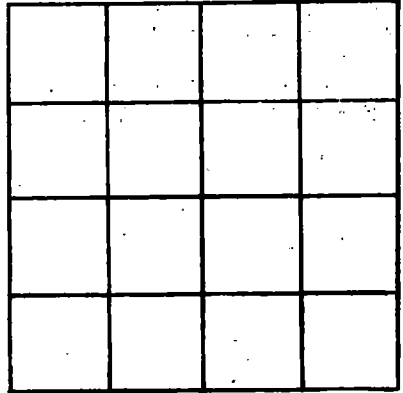

SECTION 8

Please indicate well location X.

ADDITIONAL INFORMATION

*This well is
flowing approx 1,050
gallon per hr.
Press. approx. 10 lbs.*

If more than one screen,
show locations of each on sketch.