

HANCOCK
K187
11-6-71

MISSISSIPPI
BOARD OF WATER COMMISSIONERS
416 North State Street
Jackson, Mississippi 39201

RECORDED

WATER WELL DRILLERS LOG

Nov. 6 1971 date well completed
J. J. Ward Waterwells firm name
Hancock county well located

LANDOWNER: Charlie Figel
Hwy. 90
Box St. Louis (mailing address)
WELL LOCATION:
sec. 32 T. 8 N R. 14 E
4 miles W of Box St. Louis (distance) (direction) (nearest town)

description of formations encountered	from	to
top soil	0	2
clay	2	15
Black sd.	15	33
white sd.	33	61
white clay	61	82
Shelf sd.	82	112
white sd.	112	122
Blue clay	122	142
Red sd.	142	162

WELL PURPOSE: Home (home, irrigation, municipal, industrial)


WELL COMPLETION DATA:
(1) diameter (inches) 2
(2) total depth (feet) 162
(3) static water level (feet) 6 below top of ground.
(4) casing 2" galv. (material), 157' (depth)
(5) screen 5' (length), (depth to top) 2" (size), Stainless Steel (material)
(6) pump (HP) (yield gpm)
(7) electric log NO (yes or no)
(organization running log) N/A
(8) how well bottom plugged BWV

CODED

DRILLERS REMARKS: N/A

If well telescopes please sketch and show depths.

GROUND LEVEL

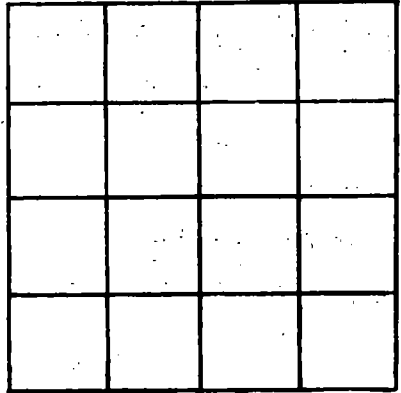

SECTION 32

Please indicate well location X.

ADDITIONAL INFORMATION

A series of 18 horizontal lines for providing additional information.

If more than one screen, show locations of each on sketch.