

HANCOCK
 R 188
 10-5-71

MISSISSIPPI
 BOARD OF WATER COMMISSIONERS DEC 16 1971
 416 North State Street
 Jackson, Mississippi 39201

WATER WELL DRILLERS LOG

CODED

Oct. 5 1971
 date well completed

J. J. Ward Water Well
 firm name

Hancock
 county well located

LANDOWNER: Archie Susich
Bay Side Park
Bay St. Louis miss
 (mailing address)

description of formations encountered	from	to
Top Soil	0	2
Clay	2	12
Black sd.	12	31
white sd.	31	63
Clay	63	84
Shells	84	93
sd.	93	115
B. Clay	115	126
sd.	126	135
sd.	126	135
Blue Clay	135	152
sd.	152	165
Blue Clay	165	183
sd.	183	220

WELL LOCATION:
 sec. 6 T. 9 N R. 14 E
9 miles SW of Bay St. Louis
 (distance) (direction) (nearest town)

WELL PURPOSE: Home
 (home, irrigation, municipal, industrial)

WELL COMPLETION DATA:

- (1) diameter (inches) 2
- (2) total depth (feet) 220'
- (3) static water level (feet) 6 below above top of ground.
- (4) casing 2" 215'
 (material) (depth)
 If telescope see back.
 (size)
- (5) screen 5'
 (length) (depth to tap)
2" Strainer Steel
 (size) (material)
- (6) pump
 (HP) (yield gpm)


 (type power)
- (7) electric log NO
 (yes or no)
N/A
 (organization running log)
- (8) how well bottom plugged B.W.

CODED

DRILLERS REMARKS:

If well telescopes please sketch and show depths.

GROUND LEVEL

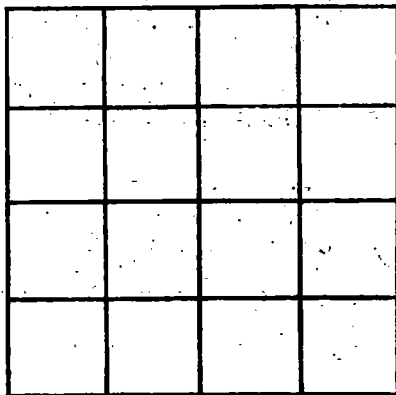

SECTION _____

Please indicate well location X.

ADDITIONAL INFORMATION

We drilled 3 holes before obtaining a good producing well. First hole was to 225' - water table - 30'. Second hole was approx. 16' away from first hole - depth 194' - water table 26'. I moved approx. 30' away from the first 2 holes - drilled and set well at 220' - water table - 6' - well pumped good for 1 well. Pump pulled well down. Put air on well and since has been pumping as expected. All three were washed & grouted. This is the first time I have encountered this - any explanation any suggestion

If more than one screen, show locations of each on sketch.