

HANCOCK
K 191
2-11-72

TPCI

MISSISSIPPI
 BOARD OF WATER COMMISSIONERS
 416 North State Street
 Jackson, Mississippi 39201

CODED

MAR 19 1972

WATER WELL DRILLERS LOG


2-11-72 19 Sutter Well Works Hancock
 date well completed firm name county well located

LANDOWNER	description of formations encountered	from	to
<u>John Chavers</u>			
<u>2446 Robt. E. Lee Blvd.</u>			
<u>New Orleans, La.</u> (mailing address)	<u>Clay</u>	<u>0</u>	<u>10</u>
	<u>Sand</u>	<u>10</u>	<u>46</u>
WELL LOCATION:	<u>Clay</u>	<u>46</u>	<u>78</u>
<u>sec. 6 T. 9 S R. 14 W</u>	<u>Sand</u>	<u>78</u>	<u>105</u>
<u>1</u> miles <u>W</u> of <u>Waveland</u> (distance) (direction) (nearest town)	<u>Clay</u>	<u>105</u>	<u>146</u>
WELL PURPOSE: <u>home</u> (home, irrigation, municipal, industrial)	<u>Sand</u>	<u>146</u>	<u>166</u>
WELL COMPLETION DATA:			
(1) diameter (inches) <u>2"</u>			
(2) total depth (feet) <u>166'</u>			
(3) static water level (feet) <u>12'</u> below top of ground.			
(4) casing <u>galv.</u> , <u>161'</u> (material) (depth)			
<u>2"</u> (size) If telescope see back.			
(5) screen <u>5'</u> , <u>161'</u> (length) (depth to top)			
<u>2"</u> , <u>stainless steel</u> (size) (material)			
(6) pump <u>1/2</u> , <u>10</u> (HP) (yield gpm)			
<u>elec.</u> (type power)			
(7) electric log <u>no</u> (yes or no)			
<u>(organization running log)</u>			
(8) how well bottom plugged <u>B.P. Valve</u>			
DRILLERS REMARKS:			

CODED

If well telescopes please sketch and show depths.

GROUND LEVEL

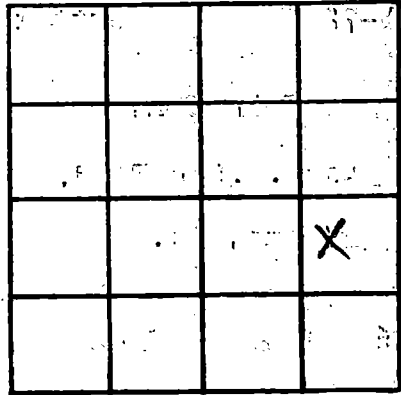

SECTION _____

Please indicate well location X.

ADDITIONAL INFORMATION

If more than one screen, show locations of each on sketch.