

HANCOCK
K192
11-22-71

MISSISSIPPI **TP CODED**
 BOARD OF WATER COMMISSIONERS
 416 North State Street
 Jackson, Mississippi 39201
MAR 18 1972

WATER WELL DRILLERS LOG


11-22 19 71 Sutter Well Works Hancock
 date well completed firm name county well located

LANDOWNER: <u>Mary E. Crowl</u>	description of formations encountered	from	to
<u>Bayside Park</u>	<u>Clay</u>	<u>0</u>	<u>12</u>
<u>Bay St. Louis, Miss.</u>	<u>Sand</u>	<u>12</u>	<u>28</u>
(mailing address)	<u>Clay</u>	<u>28</u>	<u>120</u>
WELL LOCATION:	<u>Sand & gravel</u>	<u>120</u>	<u>154</u>
sec. <u>6 T. 9 S. R. 14 W.</u>			
<u>1</u> miles <u>W</u> of <u>Waveland</u>			
(distance) (direction) (nearest town)			
WELL PURPOSE: <u>home</u>			
(home, irrigation, municipal, industrial)			
WELL COMPLETION DATA:			
(1) diameter (inches) <u>2"</u>			
(2) total depth (feet) <u>154'</u>			
(3) static water level (feet) <u>11'</u> below above top of ground.			
(4) casing <u>galv.</u> , <u>149'</u>			
(material) (depth)			
<u>2"</u> if telescope see back.			
(size)			
(5) screen <u>5'</u> , <u>149'</u>			
(length) (depth to top)			
<u>2"</u> , <u>stainless steel</u>			
(size) (material)			
(6) pump <u>unknown</u>			
(HP) (yield gpm)			
(type power)			
(7) electric log <u>no</u>			
(yes or no)			
(organization running log)			
(8) how well bottom plugged <u>B.P. Valve</u>			
DRILLERS REMARKS:			

CODED

If well telescopes please sketch and show depths.

GROUND LEVEL

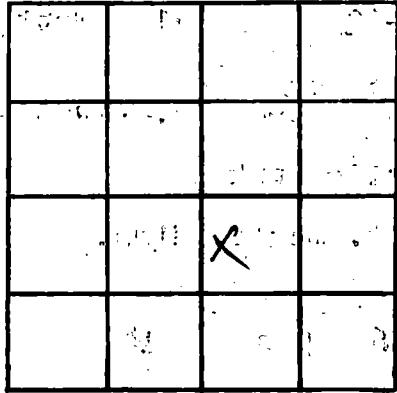

SECTION _____

Please indicate well location X.

ADDITIONAL INFORMATION

A series of horizontal lines for writing additional information, starting below the 'ADDITIONAL INFORMATION' header and extending to the bottom of the page.

If more than one screen, show locations of each on sketch.