

HANCOCK
K 194
4-29-72

MISSISSIPPI
 BOARD OF WATER COMMISSIONERS
 416 North State Street
 Jackson, Mississippi 39201

CODED

WATER WELL DRILLERS LOG

4-29 1972 Red Penton & Son Hancock
 date well completed firm name county well located

LANDOWNER:
Isaac L. Luci
Waveland, Miss.
 (mailing address)

description of formations encountered	from	to
<u>Black shale</u>	<u>0</u>	<u>8</u>
<u>White sand</u>	<u>8</u>	<u>36</u>
<u>Blue shale</u>	<u>36</u>	<u>160</u>
<u>Gray sand</u>	<u>160</u>	<u>180</u>
<u>Blue shale</u>	<u>180</u>	<u>325</u>
<u>Rock & sand</u>	<u>325</u>	<u>365</u>

WELL LOCATION:
 sec. 20 T 8 N R 14 E
1 miles N of Bay State
 (distance) (direction) (nearest town)

WELL PURPOSE: Home
 (home, irrigation, municipal, industrial)

WELL COMPLETION DATA:

(1) diameter (inches) 2 in.

(2) total depth (feet) 367

(3) static water level (feet) _____ below/above top of ground.

(4) casing Galv. 357
 (material) (depth)
 (size) if telescope see back.

(5) screen 10 ft 357
 (length) (depth to top)
2x10, 2 Steel no. 10
 (size) (material)

(6) pump _____ (HP) _____ (yield gpm)
 (type power)

(7) electric log NO
 (yes or no)
 (organization running log)

(8) how well bottom plugged
Sand pack

CODED


MAY 3 - 1972

MISS. BD. OF
 WATER COMMISSIONERS

DRILLERS REMARKS:

If well telescopes please sketch and show depths.

GROUND LEVEL

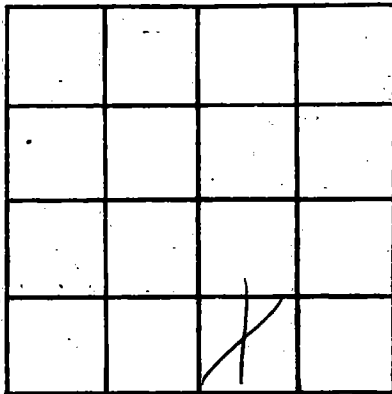

SECTION _____

Please indicate well location X.

ADDITIONAL INFORMATION

If more than one screen, show locations of each on sketch.