

HANCOCK
K 195
4-8-72

MISSISSIPPI
BOARD OF WATER COMMISSIONERS
416 North State Street
Jackson, Mississippi 39201

CODED

WATER WELL DRILLERS LOG

4-8-1972 J. T. Ward water well Hancock
date well completed firm name county well located

LANDOWNER: Ronald B. Faye

description of formations encountered

from to

Box 22

clay
sd.

0 22

Waveland, missi.
(mailing address)

clay
sd.

22 37

WELL LOCATION:

sec. 29 T. 8 N. R. 14 E. W.
9 miles NW of B.S.L.
(distance) (direction) (nearest town)

clay
sd.

37 82

82 116

116 146

146 175

WELL PURPOSE: Home
(home, irrigation, municipal, industrial)


WELL COMPLETION DATA:

- (1) diameter (inches) 2"
- (2) total depth (feet) 175'
- (3) static water level (feet) 2 below above
top of ground.
- (4) casing 2" Pvc. 170'
(material) (depth)
- If telescope see back.
(size)
- (5) screen 5' -
(length) (depth to top)
- 2" plastic
(size) (material)
- (6) pump 1/3 6
(HP) (yield gpm)
- Elco.
(type power)
- (7) electric log NO
(yes or no)
- N/A
(organization running log)
- (8) how well bottom plugged B.W.V.

CODED

DRILLERS REMARKS:

If well telescopes please sketch and show depths.

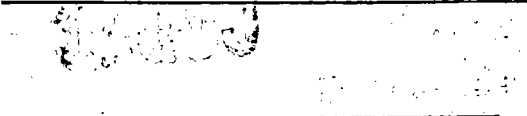

GROUND LEVEL

A vertical rectangular area for sketching well telescopes, bounded by a horizontal line at the top labeled "GROUND LEVEL" and a vertical line on the right.

SECTION 29

Please indicate well location X.

ADDITIONAL INFORMATION

A series of horizontal lines providing space for additional information.

If more than one screen, show locations of each on sketch.

