

HANCOCK
K196
4-12-72

MISSISSIPPI
 BOARD OF WATER COMMISSIONERS
 416 North State Street
 Jackson, Mississippi 39201

CODED

WATER WELL DRILLERS LOG

4-12-1972
 date well completed

J. I. Ward Water Wells
 firm name

Hancock
 county well located

LANDOWNER: Best Wax
Shoreline Park
Bay St. Louis, Miss.
 (mailing address)

description of formations encountered	from	to
	Clay	0
Silt	23	39
Clay	39	74
Silt	74	116
Clay	116	162
Silt	162	180

WELL LOCATION:
 sec. 39 T 8 N R. 14 E
9 miles N/W of B.S.L.
 (distance) (direction) (nearest town)

WELL PURPOSE: Home
 (home, irrigation, municipal, industrial)

WELL COMPLETION DATA:

(1) diameter (inches) 2"

(2) total depth (feet) 180

(3) static water level (feet) 3 below above top of ground.

(4) casing 2" Pl. 175
 (material) (depth)

- If telescope see back.
 (size)

(5) screen 5' -
 (length) (depth to top)

2" Plastic
 (size) (material)

(6) pump 1/2 9
 (HP) (yield gpm)

Elec.
 (type power)

(7) electric log NO
 (yes or no)


N/A
 (organization running log)

(8) how well bottom plugged B.W.V.


DRILLERS REMARKS: N/A

APR 17 1972

If well telescopes please sketch and show depths.

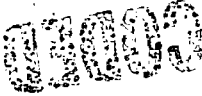

GROUND LEVEL

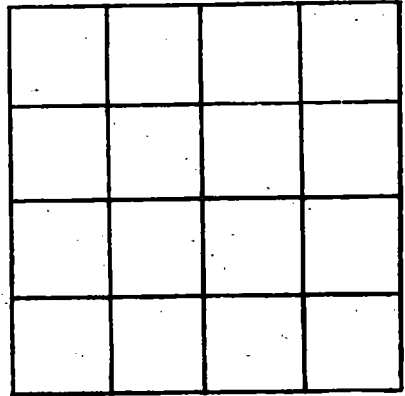

SECTION 39

Please indicate well location X.

ADDITIONAL INFORMATION

If more than one screen, show locations of each on sketch.