

**CODED**

MISSISSIPPI  
BOARD OF WATER COMMISSIONERS  
416 North State Street  
Jackson, Mississippi 39201

**WATER WELL DRILLERS LOG**

**HANCOCK**  
**K 206**  
**5-15-72**

5-15-1972 J.T. Ward Water Well Hancock  
date well completed firm name county well located

LANDOWNER: Charles McClatchey  
Pt. 2 Box 432  
Bay St. Louis, Miss.  
(mailing address)

description of formations encountered	from	to
clay + fill	0	10
sand	10	31
gray clay	31	53
white sand	53	70
clay + shell	70	86
sand	86	105

WELL LOCATION:  
sec 23 T 9 N R 14 E  
14 miles SW of BAY ST. LOUIS  
(distance) (direction) (nearest town)

WELL PURPOSE: None  
(home, irrigation, municipal, industrial)

WELL COMPLETION DATA:

(1) diameter (inches) 2"

(2) total depth (feet) 105'

(3) static water level (feet) 5' <sup>below</sup> above top of ground

(4) casing 2" plastic 100'  
(material) (depth)

— If telescope see back.  
(size)

(5) screen 5' —  
2" (length) (depth to top)  
Plastic  
(size) (material)

(6) pump — —  
(HP) (yield gpm)

—  
(type power)

(7) electric log NO  
(yes or no)

—  
(organization running log)

(8) how well bottom plugged BWV

**CODED**


AUG - 7 1972

MISS. BU.  
WATER BOARD

DRILLERS REMARKS:  
Did not install pump.

If well telescopes please sketch and show depths.

GROUND LEVEL

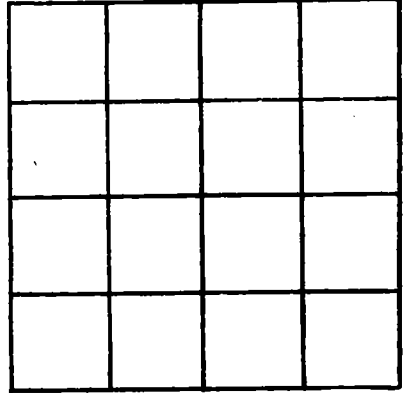

SECTION 23

Please indicate well location X.

ADDITIONAL INFORMATION

If more than one screen,  
show locations of each on sketch.