

**HANCOCK**  
**K 219**  
**10-23-72**

MISSISSIPPI  
 BOARD OF WATER COMMISSIONERS  
 416 North State Street  
 Jackson, Mississippi 39201

WATER WELL DRILLERS LOG

10-23 1972 Penton Well Serv Hancock  
 date well completed firm name county well located

LANDOWNER: Desire Dronet  
Piczyunie MISS  
 (mailing address)

description of formations encountered	from	to
Surface Clay	0	62
Sand	62	75
Blue Clay	75	160
Sand	160	195

WELL LOCATION:  
 sec 40 T 8 S R 14 W  
5 miles NW of Bay St Louis  
 (distance) (direction) (nearest town)

WELL PURPOSE: Home  
 (home, irrigation, municipal, industrial)

WELL COMPLETION DATA:

(1) diameter (inches) 2

(2) total depth (feet) 195

(3) static water level (feet) 1 below  
 top of ground.

(4) casing Galv, 190,  
 (material) (depth)  
2 if telescope see back.  
 (size)

(5) screen 5, 190,  
 (length) (depth to top)  
2, S. Steel  
 (size) (material)

(6) pump \_\_\_\_\_  
 (HP) (yield gpm)  
 (type power)

(7) electric log NO  
 (yes or no)  
 (organization running log)

(8) how well bottom plugged BW, Volvo


DRILLERS REMARKS:

NOV 15 1972

MISS. BD. OF  
 WATER

If well telescopes please sketch and show depths.

GROUND LEVEL

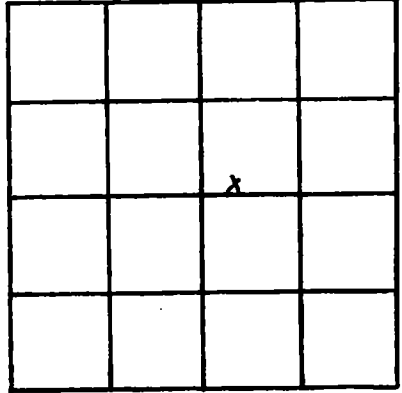

SECTION 40

Please indicate well location X.

ADDITIONAL INFORMATION

If more than one screen, show locations of each on sketch.