

**HANCOCK**  
**K 220**  
**11-9-72**

MISSISSIPPI  
 BOARD OF WATER COMMISSIONERS  
 416 North State Street  
 Jackson, Mississippi 39201  
**WATER WELL DRILLERS LOG**


11-9 19 72 Sutter Well Works Hancock  
 date well completed firm name county well located

LANDOWNER: <u>Robert S. Stimler</u>	Description of formations encountered	from	to
<u>Rt. 3 Box 6-M</u>	<u>Clay</u>	<u>0</u>	<u>20</u>
<u>Bay St. Louis, Miss.</u> (mailing address)	<u>Sand &amp; gravel</u>	<u>20</u>	<u>185</u>
<b>WELL LOCATION:</b>	<u>Clay</u>	<u>185</u>	<u>280</u>
<u>sec 37 T 8 S R 14 W</u> <u>3</u> miles <u>NW</u> of <u>Bay St. Louis</u> (distance) (direction) (nearest town)	<u>Fine sand</u>	<u>280</u>	<u>345</u>
<b>WELL PURPOSE:</b> <u>Home</u> (home, irrigation, municipal, industrial)	<u>Clay</u>	<u>345</u>	<u>408</u>
<b>WELL COMPLETION DATA:</b>	<u>Sand</u>	<u>408</u>	<u>430</u>
(1) diameter (inches) <u>2"</u>			
(2) total depth (feet) <u>430'</u>			
(3) static water level (feet) <u>1'</u> <u>below</u> above top of ground.			
(4) casing <u>galv.</u> <u>420'</u> (material) (depth) <u>2"</u> (size) If telescope see back.			
(5) screen <u>10'</u> <u>420'</u> (length) (depth to top) <u>2"</u> <u>S. S.</u> (size) (material)			
(6) pump <u>1/2</u> <u>10</u> (HP) (yield gpm) <u>elec.</u> (type power)			
(7) electric log <u>no</u> (yes or no)			
(organization running log)			
(8) how well bottom plugged <u>B. P. Valve</u>			
<b>DRILLERS REMARKS:</b>			

If well telescopes please sketch and show depths.

GROUND LEVEL

20000

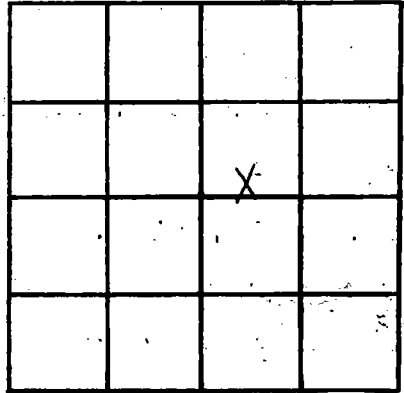

SECTION 37

Please indicate well location X.

**ADDITIONAL INFORMATION**

If more than one screen, show locations of each on sketch.