

HANCOCK
K 222
10-28-72

MISSISSIPPI
 BOARD OF WATER COMMISSIONERS
 416 North State Street
 Jackson, Mississippi 39201

WATER WELL DRILLERS LOG

10-28 19 22 J. T. WARD WATER WELLS HANCOCK
 date well completed firm name county well located

LANDOWNER: Ed DOSTER

7217 Easy St.
N.O. LA. E
 (mailing address)

WELL LOCATION:

sec. 40 T. 8 N. R. 14 E.
9 miles N/W of D.S.L.
 (distance) (direction) (nearest town)

WELL PURPOSE: HOME
 (home, irrigation, municipal, industrial)

WELL COMPLETION DATA:

- (1) diameter (inches) 2"
- (2) total depth (feet) 186
- (3) static water level (feet) 2 below top of ground.
- (4) casing 2" PLAS. 181
 (material) (depth)
- if telescope see back.
 (size)
- (5) screen 5' -
 (length) (depth to top)
- 2" PLAS.
 (size) (material)
- (6) pump 1/3 5
 (HP) (yield gpm)
- Elec.
 (type power)
- (7) electric log NO
 (yes or no)
- N/A
 (organization funding log)
- (8) how well bottom plugged BWV


description of formations encountered	from	to
	<u>Clay fill</u>	<u>0</u>
<u>sd</u>	<u>16</u>	<u>32</u>
<u>Gray Clay</u>	<u>32</u>	<u>41</u>
<u>sd.</u>	<u>41</u>	<u>122</u>
<u>Blue Clay</u>	<u>122</u>	<u>171</u>
<u>sd</u>	<u>171</u>	<u>186</u>

DEC 4 1972

DRILLERS REMARKS: This well is in Shoreline Park.

If well telescopes please sketch and show depths.

GROUND LEVEL

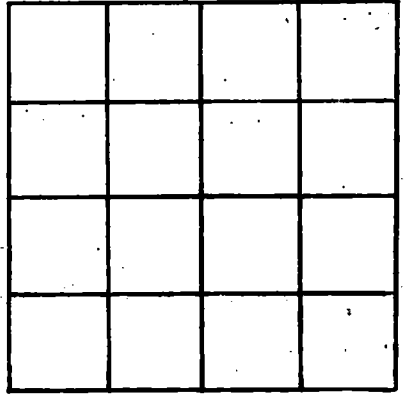

SECTION _____

Please indicate well location X.

ADDITIONAL INFORMATION

If more than one screen, show locations of each on sketch.