

HANCOCK
K 223
11-18-72

MISSISSIPPI
 BOARD OF WATER COMMISSIONERS
 416 North State Street
 Jackson, Mississippi 39201

WATER WELL DRILLERS LOG

11-18-1972 J.T. WARD WATER WELLS HANCOCK
 date well completed firm name county well located

LANDOWNER: IRVIN GREEN
LOWER BAY RD.
BAY ST. LOUIS, MISS
 (mailing address)
 WELL LOCATION:
 sec. 19 T. 8 N R. 14 E. 13
12 miles SW of B.S.L.
 (distance) (direction) (nearest town)

description of formations encountered	from	to
	<u>Top Soil - clay</u>	<u>0</u>
<u>Black S.S.</u>	<u>22</u>	<u>36</u>
<u>Gray Clay</u>	<u>36</u>	<u>84</u>
<u>Shell</u>	<u>84</u>	<u>110</u>
<u>Clay</u>	<u>110</u>	<u>180</u>
<u>90° Sand</u>	<u>180</u>	
<u>10° Clay</u>		<u>797</u>

WELL PURPOSE: HOME
 (home, irrigation, municipal, industrial)

- WELL COMPLETION DATA:
- (1) diameter (inches) 2"
 - (2) total depth (feet) 797
 - (3) static water level (feet) Flow below top of ground
 - (4) casing 5" GALV. (material), 777 (depth)
 - (size) if telescope see back.
 - (5) screen 20' (length), - (depth to top)
 - 2" (size), S.S. (material)
 - (6) pump N/A (HP), - (yield gpm)
 - (type power)
 - (7) electric log NO (yes or no)
 - N/A (organization running log)
 - (8) how well bottom plugged BWU


DEC 4 1972

DRILLERS REMARKS: From 180'
to 797 feet we had
approx. 35 feet of clay.
from 680 to 782 when

WATER COMM

If well telescopes please sketch and show depths.

GROUND LEVEL

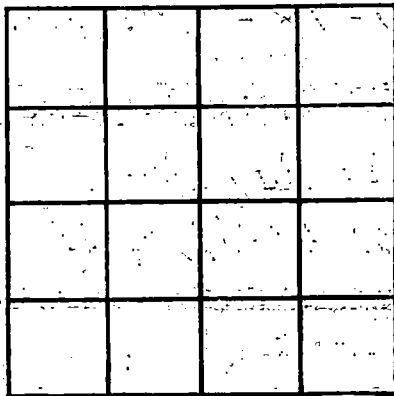

SECTION 19

Please indicate well location X.

ADDITIONAL INFORMATION

We topped our water
50. Was the most
clay we had except
for the first 100 ft.
we had approx
96 gal of fine coral
sd. will be flowing
about 1300 gal in hr.
with approx 12-13 lbs.
press.

If more than one screen,
show locations of each on sketch.