

HANCOCK
K 225
12-5-72

MISSISSIPPI
 BOARD OF WATER COMMISSIONERS
 416 North State Street
 Jackson, Mississippi 39201

CODED

WATER WELL DRILLERS LOG

12-5-72 date well completed J. T. WARD WATER well firm name Hancock county well located

LANDOWNER: Jack Brundy
Warden Island
pt. 3, Box 184 D
Bay St. Louis, miss.
 (mailing address)

description of formations encountered	from	to
Clay fill	0	16
sd-silt	16	83
Clay	83	105
Fine sd.	105	116
B. Clay	116	145
sd.	145	165

WELL LOCATION:
 sec 22 T 8 N R 14 E
 (S) (W)
5 miles NW of B.S.L.
 (distance) (direction) (nearest town)

WELL PURPOSE: Home
 (home, irrigation, municipal, industrial)

WELL COMPLETION DATA:

(1) diameter (inches) 2"

(2) total depth (feet) 165

(3) static water level (feet) 1 below top of ground. above

(4) casing 2" Plas. 150
 (material) (depth)

 (size) if telescope see back.

(5) screen 5'
 (length) (depth to top)

2" Plas.
 (size) (material)

(6) pump
 (HP) (yield gpm)

 (type power)

(7) electric log no
 (yes or no)

NIA
 (organization running log)


(8) how well bottom plugged AWV

DRILLERS REMARKS: NIA

IAN 8 1972

If well telescopes please sketch and show depths.

GROUND LEVEL

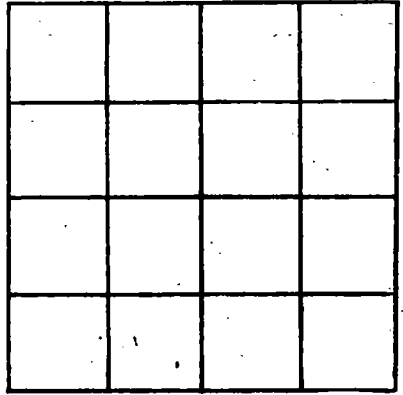

SECTION ²²~~17~~

Please indicate well location X.

ADDITIONAL INFORMATION

If more than one screen, show locations of each on sketch.