

HANCOCK

K 226

2-7-73

MISSISSIPPI BOARD OF WATER COMMISSIONERS 416 North State Street Jackson, Mississippi 39201

CODED

WATER WELL DRILLERS LOG

2-7-73

J. T. WARD WATER WELLS

HANCOCK

date well completed

firm name

county well located

LANDOWNER: LOUIS ROMERO

SHORELINE PARK

B.S.L, MISS. (mailing address)

WELL LOCATION:

sec. 40 T. 8 N R. 14 E 8 miles N/W of B.S.L (distance) (direction) (nearest town)

WELL PURPOSE: HOME (home, irrigation, municipal, industrial)

WELL COMPLETION DATA:

- (1) diameter (inches) 2"
(2) total depth (feet) 185
(3) static water level (feet) 2 below top of ground.
(4) casing 2" PLAS., 180' (material) (depth)
(5) screen 5' (length) (depth to top) 2" (size) 5, 5, (material)
(6) pump 1/2 (HP) 6 (yield gpm) Elec. (type power)
(7) electric log NO (yes or no) N/A (organization running log)
(8) how well bottom plugged BWV

description of formations encountered

from to


Table with 3 columns: description of formations encountered, from, to. Rows include: fill & clay (0-16), Black sd (16-27), Gray clay (27-36), sd (36-57), Clay (57-86), O sd. (86-92), Clay (92-106), sd (106-131), Clay (131-146), sd (146-158), Gray (158-164), sd (164-185)

CODED

DRILLERS REMARKS: N/A

If well telescopes please sketch and show depths.

GROUND LEVEL

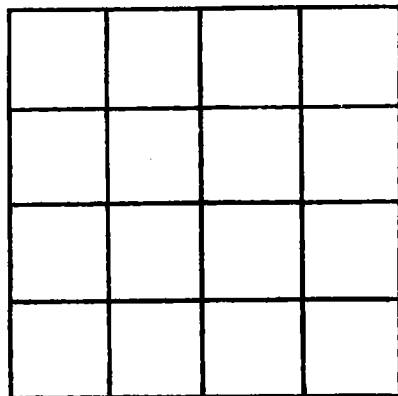

SECTION \_\_\_\_\_

Please indicate well location X.

ADDITIONAL INFORMATION

If more than one screen, show locations of each on sketch.