

HANCOCK  
K236  
6-26-73

MISSISSIPPI  
BOARD OF WATER COMMISSIONERS  
416 North State Street  
Jackson, Mississippi 39201  
WATER WELL DRILLERS LOG

**CODED**

6-26-1973 date well completed  
J.T. WARD WATER WELLS firm name  
HANCOCK county well located

LANDOWNER: Edward ybor  
Washington St.  
Bay St. Louis, Miss.  
(mailing address)

WELL LOCATION:  
sec. 36 T. 8 N. R. 14 E  
7 miles S/W of B.S.L.  
(distance) (direction) (nearest town)

WELL PURPOSE: Home  
(home, irrigation, municipal, industrial)

- WELL COMPLETION DATA:
- (1) diameter (inches) 2"
  - (2) total depth (feet) 472'
  - (3) static water level (feet) 9 (below top of ground)
  - (4) casing GALV. 462 (material) (depth)
  - (5) screen 10' (length) (depth to top)  
2" (size) S.S. (material)
  - (6) pump 1/2 (HP) 9 (yield gpm)  
Elec. (type power)
  - (7) electric log NO (yes or no)  
N/A (organization running log)
  - (8) how well bottom plugged BWU

description of formations encountered	from to	
	feet	feet
Sandy Clay -	0	21
OSD	21	32
Clay	32	65
Sd	65	83
Clay	83	91
Sd & Silt	91	192
Blue Clay	192	215
Sd	215	237
Silt - B. clay	237	386
fine - Sd	386	405
Clay	405	420
Sd	420	472


**CODED**

DRILLERS REMARKS: N/A

JUL 27 1973

If well telescopes please sketch and show depths.

GROUND LEVEL

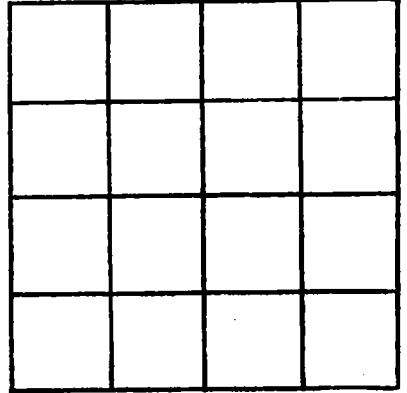

SECTION \_\_\_\_\_

Please indicate well location X.

ADDITIONAL INFORMATION

If more than one screen, show locations of each on sketch.