

HANCOCK

K 237

6-22-73

MISSISSIPPI BOARD OF WATER COMMISSIONERS
416 North State Street
Jackson, Mississippi 39201

CODED

WATER WELL DRILLERS LOG

6-22-19

J. J. WARD WATER WELLS

HANCOCK

LANDOWNER: MRS. E. MITCHELL

Lefors St. - S.L. Park

Boy St. Louis, miss.
(mailing address)

description of formations encountered

from

to

fill-clay

0 12

clay-silt
SC

12 36

36 163

163 165

WELL LOCATION:

sec. 37 T-8 N R-14 E
8 miles N/E of A.S.L.
(distance) (direction) (nearest town)

WELL PURPOSE: Home
(home, irrigation, municipal, industrial)

WELL COMPLETION DATA:

(1) diameter (inches) 2"
(2) total depth (feet) 165
(3) static water level (feet) 1 (below/above top of ground)

CODED

(4) casing PVC, 160
(material) (depth)
(size) If telescope see back.

(5) screen 5' (length), (depth to top)
2" (size), PVC (material)

(6) pump (HP) (yield gpm)
(type power)

(7) electric log no (yes or no)
N/A (organization running log)


(8) how well bottom plugged BWV

DRILLERS REMARKS: N/A

JUL 27 1973

If well telescopes please sketch and show depths.

GROUND LEVEL

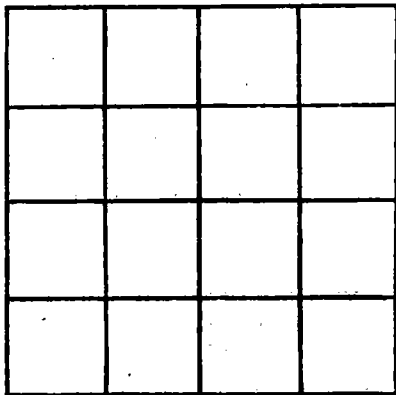

SECTION 39

Please indicate well location X.

ADDITIONAL INFORMATION

If more than one screen, show locations of each on sketch.