

K 240  
 HANCOCK  
 7-12-73

MISSISSIPPI  
 BOARD OF WATER COMMISSIONERS  
 416 North State Street  
 Jackson, Mississippi 39201

**CODED**

WATER WELL DRILLERS LOG

7-12-1973 date well completed      J.T. WARD WATER WELLS firm name      HANCOCK county well located

LANDOWNER: H.G. FILLMORE

description of formations encountered

from to

MINN. ST. SHORELINE PK.

fill

0 12

Box St. Louis, Miss.  
 (mailing address)

sd

12 35

WELL LOCATION:

sec. 39 T. 8 N. R. 14 E.

clay - silt

35 96

8 miles N/E of B.S.L.  
 (distance) (direction) (nearest town)

fine sd

96 116

WELL PURPOSE: HOME  
 (home, irrigation, municipal, industrial)

clay - silt

116 147

WELL COMPLETION DATA:

(1) diameter (inches) 2"

**CODED**

(2) total depth (feet) 165

(3) static water level (feet) 1 below top of ground.

(4) casing 2" PVC 160  
 (material) (depth)

- If telescope see back.  
 (size)

(5) screen 5' -  
 (length) (depth to top)

2" PVC  
 (size) (material)

(6) pump 1/2 7  
 (HP) (yield gpm)

Elec.  
 (type power)

(7) electric log NO  
 (yes or no)

N/A  
 (organization running log)


(8) how well bottom plugged BWW

DRILLERS REMARKS: N/A

AUG 29 1973

If well telescopes please sketch and show depths.

GROUND LEVEL

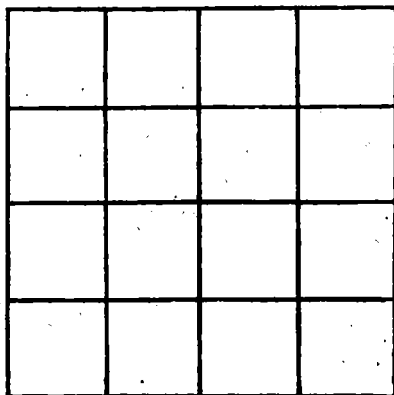

SECTION 39

Please indicate well location X.

ADDITIONAL INFORMATION

If more than one screen, show locations of each on sketch.