

MISSISSIPPI
BOARD OF WATER COMMISSIONERS
416 North State Street
Jackson, Mississippi 39201

CODED

WATER WELL DRILLERS LOG

HANCOCK
K 242
7-25-73

7-25- 19**73** J.T. WARD WATER WELLS HANCOCK
date well completed firm name county well located

LANDOWNER: Emmett Johnson
Lower Bay Rd.
Bay St. Louis, Miss.
(mailing address)

WELL LOCATION:
sec 18 T 9 N R 14 E
8 miles SW of B.S.L.
(distance) (direction) (nearest town)

WELL PURPOSE: Home
(home, irrigation, municipal, industrial)

- WELL COMPLETION DATA:
- (1) diameter (inches) 2"
 - (2) total depth (feet) 304'
 - (3) static water level (feet) 7 below above top of ground.
 - (4) casing 2" GALV 194'
(material) (depth)
 If telescope see back.
(size)
 - (5) screen 10'
(length) (depth to top)
2" S.S.
(size) (material)
 - (6) pump
(HP) (yield gpm)

(type power)
 - (7) electric log NO
(yes or no)
N/A
(organization running log)
 - (8) how well bottom plugged BWU

description of formations encountered	from	to
Soil - clay	0	14
sd	14	31
Clay - shell	31	86
sd	86	112
Clay - shell	112	226
sd - fine	226	232
Clay	236	265
sd	265	304


CODED

DRILLERS REMARKS: N/A

AUG 20 1973

If well telescopes please sketch and show depths.

GROUND LEVEL

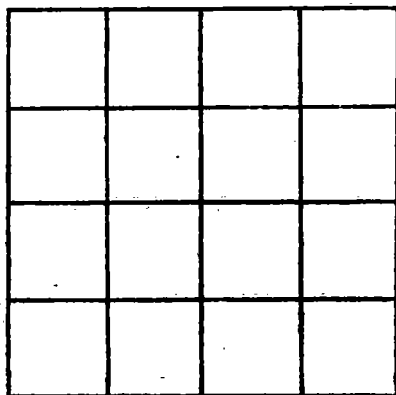

SECTION 18

Please indicate well location X.

ADDITIONAL INFORMATION

If more than one screen, show locations of each on sketch.