

HANCOCK

K245

7-18-73

MISSISSIPPI BOARD OF WATER COMMISSIONERS
416 North State Street
Jackson, Mississippi 39201

CODED

WATER WELL DRILLERS LOG

7-18 1973 Sutter Well Works Hancock
date well completed firm name county well located

LANDOWNER: John Bolian

4635 Gawain Dr.

New Orleans, La 70127
(mailing address)

WELL LOCATION:

sec. 40 T. 8 S. R. 14 W.
4 miles NW of Bay St Louis
(distance) (direction) (nearest town)

WELL PURPOSE: home
(home, irrigation, municipal, industrial)

WELL COMPLETION DATA:

- (1) diameter (inches) 2"
- (2) total depth (feet) 110'
- (3) static water level (feet) 4' below top of ground.
- (4) casing galv. 105'
(material) (depth)
2" if telescope see back.
(size)
- (5) screen 5' 105'
(length) (depth to top)
2" stainless steel
(size) (material)
- (6) pump none
(HP) (yield gpm)
(type power)
- (7) electric log no
(yes or no)
(organization running log)
- (8) how well bottom plugged B.P. Valve

description of formations encountered

from to

Clay	0	10
Sand	10	57
Clay	57	83
Sand & gravel	83	110

CODED


DRILLERS REMARKS:

SEP 5 1973

Miss. Bd. of
Water Comm.

If well telescopes please sketch and show depths.

GROUND LEVEL

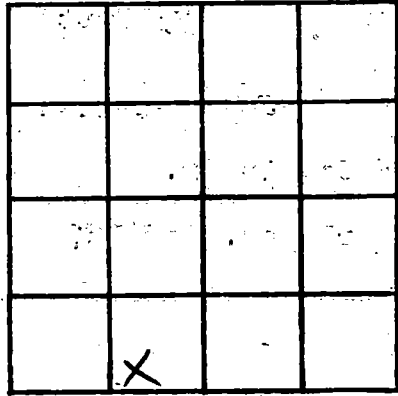

SECTION 40

Please indicate well location X.

ADDITIONAL INFORMATION

If more than one screen, show locations of each on sketch.