

all done
HANCOCK
K 246
5-31-73

MISSISSIPPI
 BOARD OF WATER COMMISSIONERS
 416 North State Street
 Jackson, Mississippi 39201

CODED

WATER WELL DRILLERS LOG

May 31 19 73 Sutter Well Works Hancock
 date well completed firm name county well located

LANDOWNER: Mr. Jerry Wilson Rt. 3 Box 57 Bay St. Louis, Miss. (mailing address)	description of formations encountered	from	to
	clay	0	18
	sand	18	36
	clay	36	360
	sand	360	430
	clay	430	518
	sand	518	556

WELL LOCATION:
 sec. 26 T. 8 R. 14
 1 miles W of Bay St. Louis
 (distance) (direction) (nearest town)

CODED


WELL PURPOSE: home
 (home, irrigation, municipal, industrial)

- WELL COMPLETION DATA:
- (1) diameter (inches) 2"
 - (2) total depth (feet) 556'
 - (3) static water level (feet) ^{below} above top of ground.
 - (4) casing galv. 546'
 (material) (depth)
 2" If telescope see back.
 (size)
 - (5) screen 10' 546'
 (length) (depth to top)
 2" stainless steel
 (size) (material)
 - (6) pump 1/2 15
 (HP) (yield gpm)
 elec.
 (type power)
 - (7) electric log no
 (yes or no)
 (organization running log)
 - (8) how well bottom plugged B.P. Valve

DRILLERS REMARKS: SEP 7 1973
 MISS. BD. OF WATER COMM.

If well telescopes please sketch and show depths.

GROUND LEVEL

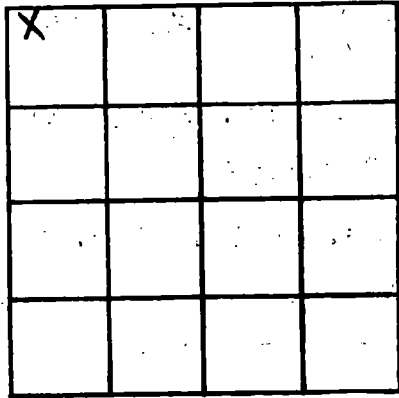

SECTION _____

Please indicate well location X.

ADDITIONAL INFORMATION

If more than one screen, show locations of each on sketch.