

**HANCOCK**  
**K 249**  
**9-17-73**

MISSISSIPPI  
 BOARD OF WATER COMMISSIONERS  
 416 North State Street  
 Jackson, Mississippi 39201

**CODED**

**WATER WELL DRILLERS LOG**

9-17-1973 Wood Well Drilling Hancock  
 date well completed firm name county well located

LANDOWNER: M. H. Finnegan

Bankcroft St.

description of formations encountered

from to

Shoreline Pk. - B.S.L. main  
 (mailing address)

fill clay  
sd  
gray clay  
clay  
sd. fine  
clay - silt  
sd -

0 14  
14 35  
35 50  
50 86  
86 101  
101 115  
115 155  
155 170

WELL LOCATION:

sec. 29 T 8 N R 14 E  
8 miles N/W of B.S.L.  
 (distance) (direction) (nearest town)

WELL PURPOSE: Home  
 (home, irrigation, municipal, industrial)

WELL COMPLETION DATA:

- (1) diameter (inches) 2"
- (2) total depth (feet) 170'
- (3) static water level (feet) 2 <sup>below</sup> <sub>above</sub> top of ground.
- (4) casing 2" PVC, 165'  
 (material) (depth)

**CODED**

— if telescope see back.  
 (size)

- (5) screen 5', —  
 (length) (depth to top)  
2", PVC  
 (size) (material)

- (6) pump —, —  
 (HP) (yield gpm)  
—  
 (type power)

- (7) electric log NO  
 (yes or no)  
W/A  
 (organization running log)

- (8) how well bottom plugged BWD


DRILLERS REMARKS:

the well right next to  
Juneau Well.  
formations - very little chg.

1973  
 OF  
 COMM

If well telescopes please  
sketch and show depths.

GROUND LEVEL

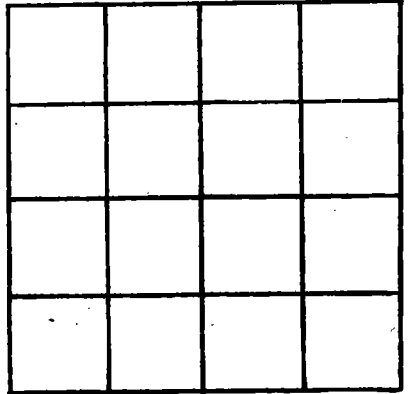

SECTION 29

Please indicate well location X.

ADDITIONAL INFORMATION

If more than one screen,  
show locations of each on sketch.