

**HANCOCK**  
**K250**  
**9-18-73**

MISSISSIPPI  
 BOARD OF WATER COMMISSIONERS  
 416 North State Street  
 Jackson, Mississippi 39201

**CODED**

**WATER WELL DRILLERS LOG**

9-18-1973 date well completed  
 Ward Well Drilling firm name  
 Hancock county well located

LANDOWNER: S. J. Rhodes  
Oregon St.  
Shakline Pt. - B.S.L., Miss  
 (mailing address)

description of formations encountered	from	to
Fill - Clay	0	12
sd	12	35
Aug clay	35	56
sd	56	81
Clay - Silt	81	120
sd	120	135

WELL LOCATION:  
 sec 40 T 8 N R 14 E  
10 miles N/W of B.S.L.  
 (distance) (direction) (nearest town)

WELL PURPOSE: Home  
 (home, irrigation, municipal, industrial)

- WELL COMPLETION DATA:
- (1) diameter (inches) 2"
- (2) total depth (feet) 125
- (3) static water level (feet) 2 <sup>(below)</sup> <sub>(above)</sub> top of ground.
- (4) casing 2" PVC 130  
 (material) (depth)
- If telescope see back.  
 (size)
- (5) screen 5' —  
 (length) (depth to top)
- 2" PVC  
 (size) (material)
- (6) pump 1/2 7  
 (HP) (yield gpm)
- Elec.  
 (type power)
- (7) electric log NO  
 (yes or no)  
N/A  
 (organization running log)
- (8) how well bottom plugged BWU

**CODED**


DRILLERS REMARKS: N/A

**OCT 15 1973**

MISS. BD. OF  
 WATER COM.

If well telescopes please sketch and show depths.

GROUND LEVEL

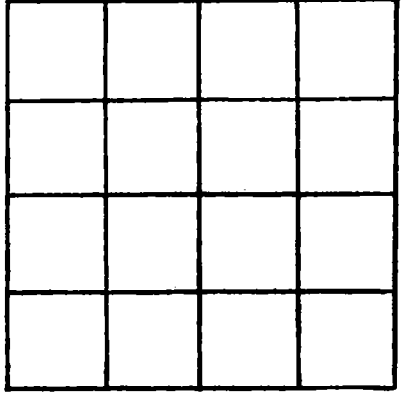

SECTION 46

Please indicate well location X.

ADDITIONAL INFORMATION

If more than one screen, show locations of each on sketch.