

**HANCOCK**  
**K258**  
**11-29-73**

MISSISSIPPI  
 BOARD OF WATER COMMISSIONERS  
 416 North State Street  
 Jackson, Mississippi 39201

CODED

WATER WELL DRILLERS LOG

11-29-1973 date well completed      INWARD WELL DLG. firm name      HANCOCK county well located

LANDOWNER: FILLMORE DITMER

description of formations encountered

from to

LOWER BAY RD

Soil-clay

0 15

BAY ST. LOUIS, MISS.  
 (mailing address)

sd  
 Heavy clay & shell

15 31  
 31 86

WELL LOCATION:

sec. 9 T. 9 N. R. 14 E  
8 miles S/W of B.S.L.  
 (distance) (direction) (nearest town)

sd  
 clay-silt

86 110  
 110 220

WELL PURPOSE: HOME  
 (home, irrigation, municipal, industrial)

sd  
 clay

220 231  
 231 265

WELL COMPLETION DATA:

- (1) diameter (inches) 2"
- (2) total depth (feet) 301
- (3) static water level (feet) 9 below top of ground.
- (4) casing 2" PVC, 296  
 (material) (depth)
- \_\_\_\_\_ If telescope see back.  
 (size)
- (5) screen 5' \_\_\_\_\_  
 (length) (depth to top)
- \_\_\_\_\_ 2" \_\_\_\_\_  
 (size) (material)
- (6) pump 1 14  
 (HP) (yield gpm)
- \_\_\_\_\_ Elec. \_\_\_\_\_  
 (type power)
- (7) electric log NO  
 (yes or no)
- \_\_\_\_\_ N/A \_\_\_\_\_  
 (organization running log)
- (8) how well bottom plugged BWU

CODED


DRILLERS REMARKS: N/A

DEC 26 1973

MISS. BOARD OF WATER COMMISSIONERS

If well telescopes please sketch and show depths.

GROUND LEVEL

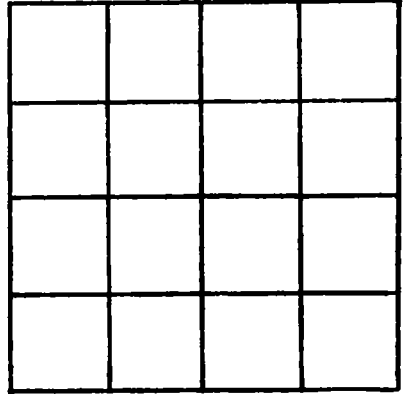

SECTION 9

Please indicate well location X.

ADDITIONAL INFORMATION

Lined area for additional information.

If more than one screen, show locations of each on sketch.