

HANCOCK
K 262
2-19-74

MISSISSIPPI
BOARD OF WATER COMMISSIONERS
416 North State Street
Jackson, Mississippi 39201

CODED

WATER WELL DRILLERS LOG

2-19 1974 Woodwell Dr. Hancock
date well completed firm name county well located

LANDOWNER: Ozola Hernandez
Magia St. Thelma Pl.
Box St. Louis, Miss.
(mailing address)

description of formations encountered	from	to
<u>fill on clay</u>	<u>0</u>	<u>14</u>
<u>SC</u>	<u>14</u>	<u>46</u>
<u>clay</u>	<u>46</u>	<u>95</u>
<u>sgt - fine</u>	<u>95</u>	<u>112</u>
<u>clay</u>	<u>112</u>	<u>135</u>
<u>sgt</u>	<u>135</u>	<u>151</u>


WELL LOCATION:
sec. 28 T 8 N R 14 E
7 miles N of B.S.L.
(distance) (direction) (nearest town)

WELL PURPOSE: Home
(home, irrigation, municipal, industrial)

- WELL COMPLETION DATA:
- (1) diameter (inches) 2"
 - (2) total depth (feet) 15'
 - (3) static water level (feet) 3 ^{below} top of ground
 - (4) casing 2" PVC 146
(material) (depth)
 - if telescope see back.
(size)
 - (5) screen 5' -
(length) (depth to top)
 - 2" PVC
(size) (material)
 - (6) pump 1/2 8
(HP) (yield gpm)
 - Elec.
(type power)
 - (7) electric log NO
(yes or no)
 - N/A
(organization running log)
 - (8) how well bottom plugged BWC


CODED

DRILLERS REMARKS: N/A

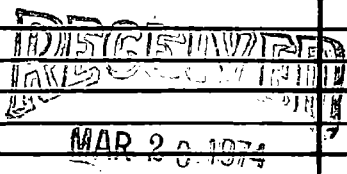

If well telescopes please sketch and show depths.

GROUND LEVEL

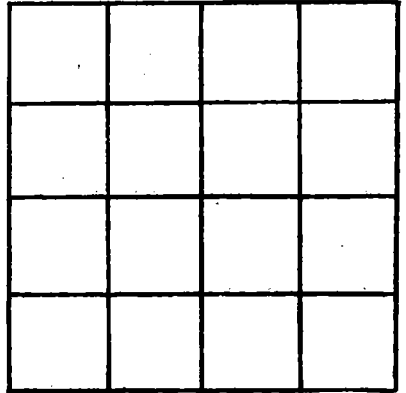

SECTION _____

Please indicate well location X.

ADDITIONAL INFORMATION

If more than one screen, show locations of each on sketch.