

HANCOCK
K 264
2-14-74

MISSISSIPPI
 BOARD OF WATER COMMISSIONERS
 416 North State Street
 Jackson, Mississippi 39201

CODED

WATER WELL DRILLERS LOG

2-14 1974 WARD WELL DLG. HANCOCK
 date well completed firm name county well located

LANDOWNER: JATE Co.
906 ROYAL ST.
N.O., LA.
 (mailing address)


WELL LOCATION:
 sec. 9 T. 8 N. R. 14 E
2 miles west of Waveland
 (distance) (direction) (nearest town)

WELL PURPOSE: IRRIGATION
 (home, irrigation, municipal, industrial)

- WELL COMPLETION DATA:
- (1) diameter (inches) 2
 - (2) total depth (feet) 714
 - (3) static water level (feet) 8 below top of ground. above
 - (4) casing GALV. 196
 (material) (depth)
— if telescope see back.
 (size)
 - (5) screen 20' —
 (length) (depth to top)
2" S.S.
 (size) (material)
 - (6) pump 1 12
 (HP) (yield gpm)
Elec.
 (type power)
 - (7) electric log NO
 (yes or no)
N/A
 (organization running log)
 - (8) how well bottom plugged BWV

description of formations encountered	from	to
Top Soil - clay	0	12
sd	12	53
clay w/ shell	53	90
sd	90	112
clay	112	150
sd	150	200
clay-silt	200	280
sd - Good	280	325
clay-silt	325	340
sd	340	375
clay	375	415
sd	415	442
clay	442	486
sd - Good	486	525
clay	525	620
sd - Good	620	714

CODED

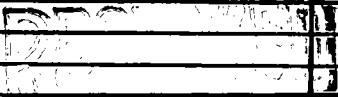

MAR 20 1974

DRILLERS REMARKS: Well
was drilled on wood st
in Waveland -

