

HANCOCK
K266
4-8-74

MISSISSIPPI
 BOARD OF WATER COMMISSIONERS
 416 North State Street
 Jackson, Mississippi 39201

CODED

WATER WELL DRILLERS LOG

4-8-1974 date well completed Wardwell Dly. firm name Hancock county well located

LANDOWNER: Anthony Saleo
Box 248 - Logan St.
Waveland, Miss.
 (mailing address)

description of formations encountered	from	to
top Soils & Fill	0	16
sd	16	31
clay	31	40
sd	40	86
clay	86	110
sd - fine	110	121
clay	121	140
sd	140	165

WELL LOCATION:
 sec. 40 T 8 N R. 14 E
8 miles N of B.S.L
 (distance) (direction) (nearest town)


WELL PURPOSE: Home
 (home, irrigation, municipal, industrial)

WELL COMPLETION DATA:

- (1) diameter (inches) 2"
- (2) total depth (feet) 165
- (3) static water level (feet) 1 below above top of ground.
- (4) casing PVC 160'
 (material) (depth)
 if telescope see back.
 (size)
- (5) screen 5'
 (length) (depth to top)
2" PVC SCH 80
 (size) (material)
- (6) pump 1/2 7
 (HP) (yield gpm)
Elec.
 (type power)
- (7) electric log no
 (yes or no)
N/A
 (organization running log)
- (8) how well bottom plugged BWU


CODED

DRILLERS REMARKS: N/A

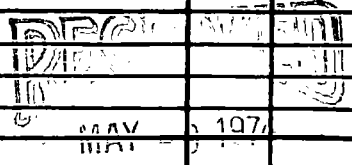

If well telescopes please sketch and show depths.

GROUND LEVEL

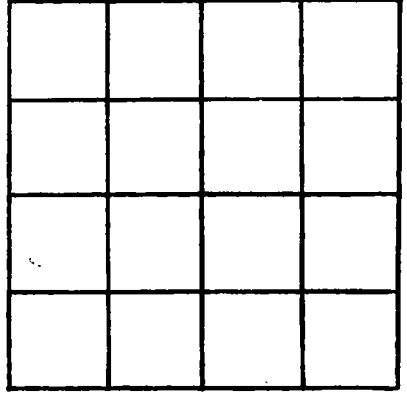

SECTION _____

Please indicate well location X.

ADDITIONAL INFORMATION

If more than one screen, show locations of each on sketch.