

Hancock
K271
5-2-74

MISSISSIPPI
BOARD OF WATER COMMISSIONERS
416 North State Street
Jackson, Mississippi 39201

CODED.

WATER WELL DRILLERS LOG

5-2-74 date well completed
Litter Wood Works firm name
Hancock county well located

LANDOWNER: Paul Burst
76 Glenwood Ave.
Harrahan, La. 70123
(mailing address)

description of formations encountered	depth	
	from	to
Clay	0	18
Sand	18	115
Clay	115	186
Sand	186	214


WELL LOCATION:
sec. 40 T 8 S R 14 E
5 miles W of Bay St. Louis
(distance) (direction) (nearest town)

WELL PURPOSE: home
(home, irrigation, municipal, industrial)

WELL COMPLETION DATA:

- (1) diameter (inches) 2"
- (2) total depth (feet) 214'
- (3) static water level (feet) 1' below top of ground.
- (4) casing galv. 210' (material) (depth)
2" (size) if telescope see back.
- (5) screen 4' 210' (length) (depth to top)
2" (size) Mod-Stainless Steel (material)
- (6) pump none (HP) (yield gpm)
(type power)
- (7) electric log no (yes or no)
(organization running log)
- (8) how well bottom plugged BP Valve

CODED

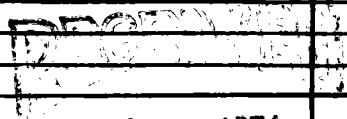

JUL - 5 1974

DRILLERS REMARKS:

If well telescopes please sketch and show depths.

GROUND LEVEL

X			

SECTION 40

Please indicate well location X.

ADDITIONAL INFORMATION

If more than one screen, show locations of each on sketch.