

Hancock  
K 272  
6-19-74

MISSISSIPPI  
BOARD OF WATER COMMISSIONERS  
416 North State Street  
Jackson, Mississippi 39201

CODED

WATER WELL DRILLERS LOG

6-19 1974 Sutter Wood Works Hancock  
date well completed firm name county well located

LANDOWNER: WALTER BOEHM  
RT 3 Box 410-G  
BAY ST. LOUIS MISS  
(mailing address)

description of formations encountered	from	to
Clay	0	12
sand	12	50
Clay	50	101
sand & gravel	101	150
Clay	150	154

WELL LOCATION:  
sec. 40 T 8 N R 14 E  
4 miles W of Bay St Louis  
(distance) (direction) (nearest town)

WELL PURPOSE: Home  
(home, irrigation, municipal, industrial)

- WELL COMPLETION DATA:
- (1) diameter (inches) 2"
  - (2) total depth (feet) 147'
  - (3) static water level (feet) 4' below top of ground.
  - (4) casing galv. 142' (material) (depth)  
2" (size) If telescope see back.
  - (5) screen 5' 142' (length) (depth to top)  
2" stainless steel (size) (material)
  - (6) pump 1/2 10 (HP) (yield gpm)  
elec (type power)
  - (7) electric log No (yes or no)

CODED

RECEIVED


JUL 5 1974

(organization running log)  
(8) how well bottom plugged BPI/Valu

DRILLERS REMARKS:

If well telescopes please sketch and show depths.

GROUND LEVEL

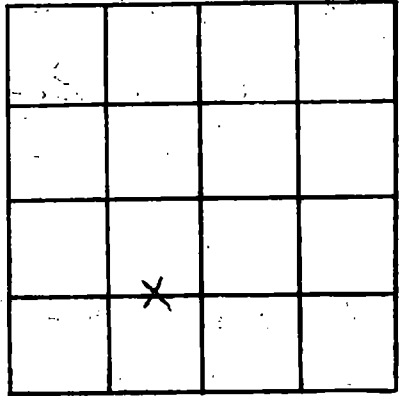

SECTION 40

Please indicate well location X.

ADDITIONAL INFORMATION

Multiple horizontal lines for writing additional information.

If more than one screen, show locations of each on sketch.