

Hancock  
K274  
5-6-74

MISSISSIPPI  
BOARD OF WATER COMMISSIONERS  
416 North State Street  
Jackson, Mississippi 39201

CODED

WATER WELL DRILLERS LOG

5-6 1974 date well completed  
Sutter Well Works firm name  
Hancock county well located

LANDOWNER: SHERMAN WILKINSON

813 SADIE AVE

METAIRIE LA  
(mailing address)

WELL LOCATION:

sec. 37 T 8 S R 14 W  
2 miles NW of Baytown  
(distance) (direction) (nearest town)

WELL PURPOSE: Home  
(home, irrigation, municipal, industrial)

WELL COMPLETION DATA:

- (1) diameter (Inches) 2"
- (2) total depth (feet) 383'
- (3) static water level (feet) 1/2' ~~below~~ above top of ground.
- (4) casing galv. 378'  
(material) (depth)  
2" if telescope see back.  
(size)
- (5) screen 5' 378'  
(length) (depth to top)  
2" stainless steel  
(size) (material)
- (6) pump 1/2 10  
(HP) (yield gpm)  
elec  
(type power)
- (7) electric log no  
(yes or no)


(organization running log)

(8) how well bottom plugged BP Value

DRILLERS REMARKS:

description of formations encountered	from	to
Clay	0	23
sand	23	108
Clay	108	150
fine sand-clay	150	170
Clay	170	258
sand	258	282
Clay	282	363
sand	363	383


CODED

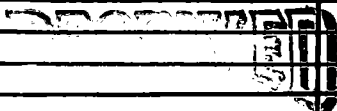

JUL - 5 1974

If well telescopes please sketch and show depths.

GROUND LEVEL

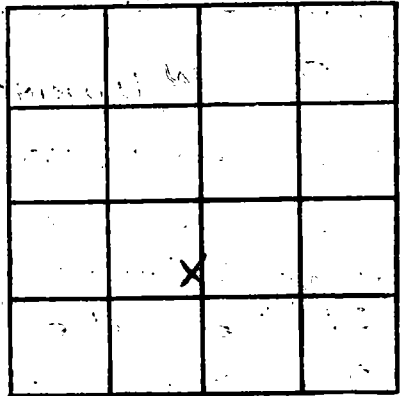

SECTION 37

Please indicate well location X.

ADDITIONAL INFORMATION

If more than one screen,  
show locations of each on sketch.