

HANCOCK
K276
7-11-74

MISSISSIPPI
 BOARD OF WATER COMMISSIONERS
 416 North State Street
 Jackson, Mississippi 39201

CODED

WATER WELL DRILLERS LOG

July 11 1974 Wood Well Drilling Hancock
 date well completed firm name county well located

LANDOWNER: Sadner's
Seafood, Washington ave.
Bay St. Louis, Miss.
 (mailing address)

WELL LOCATION:
 sec. 29 T 9 N R. 14 E
8 miles West of Waveland
 (distance) (direction) (nearest town)

WELL PURPOSE: Industrial
 (home, irrigation, municipal, industrial)

- WELL COMPLETION DATA:
- (1) diameter (inches) 2"
 - (2) total depth (feet) 835'
 - (3) static water level (feet) 20 below top of ground. above
 - (4) casing 2" Galv. 815'
 (material) (depth)
 - _____ If telescope see back.
 (size)
 - (5) screen 20' _____
 (length) (depth to top)
 - 2" S.S.
 (size) (material)
 - (6) pump _____
 (HP) (yield gpm)
 - _____ (type power)
 - (7) electric log NO
 (yes or no)
N/A
 (organization running log)
 - (8) how well bottom plugged 3WV

description of formations encountered	from	to
fill-clay	0	21
sd	21	30
clay-silt	30	130
Red gravel	130	196
sd clay-silt	196	225
sd	225	362
clay-silt	362	440
sd	440	515
clay-silt	515	568
sd	568	590
clay-silt	590	612
sd	612	658
clay-silt	658	785
sd	785	835

CODED


RECEIVED

AUG - 1 1974

DRILLERS REMARKS: Water
flowed 24 gal. per min.
at 14 lb. pressure.

If well telescopes please sketch and show depths.

GROUND LEVEL

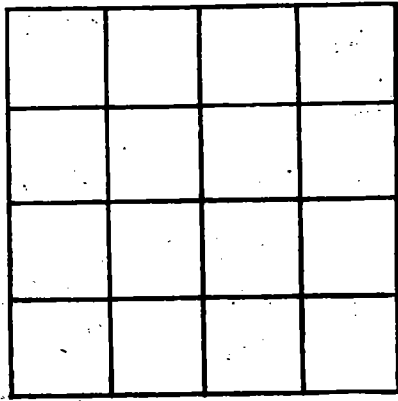

SECTION 29

Please indicate well location X.

ADDITIONAL INFORMATION

If more than one screen, show locations of each on sketch.

Handwritten signature or initials in the bottom right corner of the page.