

**HANCOCK**  
**K 277**  
**7-20-74**

MISSISSIPPI  
 BOARD OF WATER COMMISSIONERS  
 416 North State Street  
 Jackson, Mississippi 39201

**CODED**

**WATER WELL DRILLERS LOG**

July 20 1974 Wood Well Drilling Hancock  
 date well completed firm name county well located

LANDOWNER:	description of formations encountered	from	to
<u>George Smith</u>			
<u>Robin St.</u>	<u>fill - clay</u>	<u>0</u>	<u>20</u>
<u>Bay St. Louis, Miss.</u>	<u>sd</u>	<u>20</u>	<u>35</u>
(mailing address)	<u>clay - silt</u>	<u>35</u>	<u>195</u>
	<u>sd</u>	<u>195</u>	<u>225</u>

WELL LOCATION:  
 sec. 33T-8N R-14E  
6 miles N/E of B.S.L.  
 (distance) (direction) (nearest town)

WELL-PURPOSE: Home  
 (home, irrigation, municipal, industrial)

- WELL COMPLETION DATA:
- (1) diameter (inches) 2"
  - (2) total depth (feet) 225'
  - (3) static water level (feet) 1 below top of ground above
  - (4) casing 2" PVC, 220  
 (material) (depth)  
- (size) if telescope see back.
  - (5) screen 5', -  
 (length) (depth to top)  
2", SCH 80 PVC  
 (size) (material)
  - (6) pump 1/2, 7  
 (HP) (yield gpm)  
elec.  
 (type power)
  - (7) electric log NO  
 (yes or no)  
N/A  
 (organization running log)
  - (8) how well bottom plugged BWU

**CODED**


**RECEIVED**

**AUG 1 1974**

DRILLERS REMARKS: N/A

If well telescopes please sketch and show depths.

GROUND LEVEL

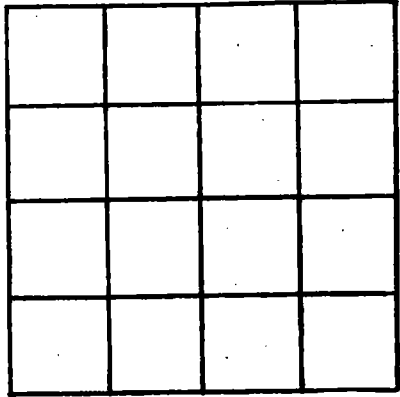

SECTION 32

Please indicate well location X.

ADDITIONAL INFORMATION

If more than one screen, show locations of each on sketch.