

HANCOCK
K279
7-25-74

MISSISSIPPI
 BOARD OF WATER COMMISSIONERS
 416 North State Street
 Jackson, Mississippi 39201

CODED

WATER WELL DRILLERS LOG

July 25 1974 Wood Well Drilling Hancock
 (date well completed) (firm name) (county well located)

LANDOWNER: <u>Allen Sims</u>	description of formations encountered	from	to
<u>Ala. St. - Shalene Park</u>			
<u>Boy St. Louis, miss.</u> (mailing address)	<u>fill</u>	<u>0</u>	<u>15</u>
	<u>sd</u>	<u>15</u>	<u>56</u>
	<u>clay silt</u>	<u>56</u>	<u>112</u>
	<u>sd - fine</u>	<u>112</u>	<u>131</u>
	<u>clay - silt</u>	<u>131</u>	<u>156</u>
	<u>sd - med.</u>	<u>156</u>	<u>176</u>

WELL LOCATION:
 sec. 40 T. 8 N. R. 14 E.
8 miles N/E of B.S.L.
 (distance) (direction) (nearest town)

WELL PURPOSE: Home
 (home, irrigation, municipal, industrial)

- WELL COMPLETION DATA:
- (1) diameter (inches) 2"
 - (2) total depth (feet) 176 ft.
 - (3) static water level (feet) 2 below above top of ground.
 - (4) casing 2" PUC, 171'
 (material) (depth)
 - (size) If telescope see back.
 - (5) screen 5' -
 (length) (depth to top)
 - 2" SCH 80 PUC
 (size) (material)
 - (6) pump 1 10
 (HP) (yield gpm)
 - elec.
 (type power)
 - (7) electric log NO
 (yes or no)
 - N/A
 (organization running log)
 - (8) how well bottom plugged BWU

CODED


DECEASED

AUG - 1 1974

DRILLERS REMARKS: N/A

If well telescopes please sketch and show depths.

GROUND LEVEL

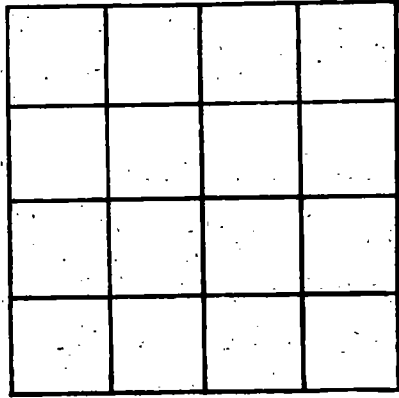

SECTION 40

Please indicate well location X.

ADDITIONAL INFORMATION

If more than one screen, show locations of each on sketch.