

**HANCOCK**  
**K281**  
**8/23/74**

MISSISSIPPI  
 BOARD OF WATER COMMISSIONERS  
 416 North State Street  
 Jackson, Mississippi **CODED**

**WATER WELL DRILLERS LOG**

Aug. 23  
 date well completed

1974 Ward Well Drilling  
 firm name

Hancock  
 county well located

LANDOWNER: Joe Williams  
Green Meadow Rd.  
Bay St. Louis, Miss.  
 (mailing address)

description of formations encountered	from	to
<u>fill - clay</u>	<u>0</u>	<u>17</u>
<u>clay</u>	<u>17</u>	<u>35</u>
<u>clay</u>	<u>35</u>	<u>107</u>
<u>clay - silt</u>	<u>107</u>	<u>116</u>
<u>ss</u>	<u>116</u>	<u>388</u>
<u>ss</u>	<u>388</u>	<u>428</u>

WELL LOCATION:  
 sec. 27 T. 8 N. R. 14 E.  
3 miles N/E of B.S.L.  
 (distance) (direction) (nearest town)

WELL PURPOSE: Home  
 (home, irrigation, municipal, industrial)

- WELL COMPLETION DATA:
- (1) diameter (inches) 2"
  - (2) total depth (feet) 428'
  - (3) static water level (feet) 3'  below  above top of ground.
  - (4) casing Pvc 418  
 (material) (depth)
  - (size) If telescope see back.
  - (5) screen 10' -  
 (length) (depth to top)
  - 2" SCH. 80 Pvc  
 (size) (material)
  - (6) pump - -  
 (HP) (yield gpm)
  - (type power)
  - (7) electric log N/A  
 (yes or no)
  - N/A  
 (organization running log)
  - (8) how well bottom plugged BWW


**CODED**

**RECEIVED**  
**SEP 18 1974**

DRILLERS REMARKS: N/A

If well telescopes please sketch and show depths.

GROUND LEVEL

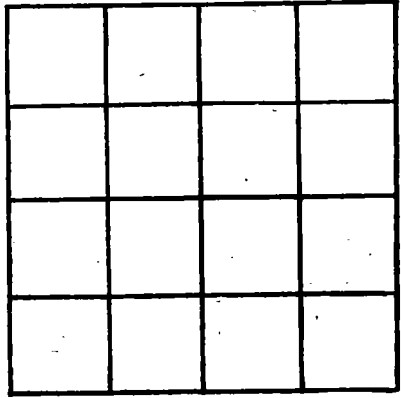

SECTION 32

Please indicate well location X.

ADDITIONAL INFORMATION

If more than one screen, show locations of each on sketch.