

HANCOCK
 K 282
 8/22/74

MISSISSIPPI
 BOARD OF WATER COMMISSIONERS
 416 North State Street
 Jackson, Mississippi 39201

CODED

WATER WELL DRILLERS LOG

Aug. 22 1974 Ward Well Drilling Hancock
 date well completed firm name county well located

LANDOWNER: S. Gilbert
 new york St. - Shoreline Park
 Bay St. Louis, miss
 (mailing address)

description of formations encountered	from	to
Fill	0	12
Sd	12	42
clay	42	95
Sd - Fine	95	120
clay - silt	120	158
Sd	158	178

WELL LOCATION:
 sec 39T 8 N R 14 E
 8 miles N 1/2 of B.S.L.
 (distance) (direction) (nearest town)

WELL PURPOSE: Home
 (home, irrigation, municipal, industrial)

WELL COMPLETION DATA:

(1) diameter (inches) 2"

(2) total depth (feet) 178

(3) static water level (feet) 2 below top of ground.

(4) casing PVC 173
 (material) (depth)

(size) If telescope see back.

(5) screen 5' (length) (depth to top)
 2" SCH. 80 PVC
 (size) (material)

(6) pump (HP) (yield gpm)
 (type power)

(7) electric log NO (yes or no)
 N/A (organization running log)

(8) how well bottom plugged BWU

CODED


REC-117-174
 SEP 18 1974

DRILLERS REMARKS: N/A

MISS. BD. OF WATER COMMISSIONERS

If well telescopes please sketch and show depths.

GROUND LEVEL

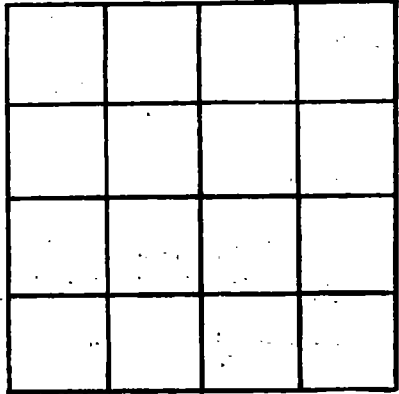

SECTION 39

Please indicate well location X.

ADDITIONAL INFORMATION

If more than one screen, show locations of each on sketch.