

**HANCOCK**  
 #283  
 8/15/74

MISSISSIPPI  
 BOARD OF WATER COMMISSIONERS  
 416 North State Street  
 Jackson, Mississippi 39201

WATER WELL DRILLERS LOG CODED

Aug 15 1974 Ward Well Drilling Hancock  
 date well completed firm name county well located

LANDOWNER: Melvin Mitchell  
Lower Bay Rd.  
Bay St. Louis miss  
 (mailing address)

WELL LOCATION:  
 sec. 13 T-9 N R-14 E  
10 miles West of B.S.L.  
 (distance) (direction) (nearest town)

WELL PURPOSE: Home  
 (home, irrigation, municipal, industrial)

WELL COMPLETION DATA:

(1) diameter (inches) 2"

(2) total depth (feet) 285'

(3) static water level (feet) 7 <sup>below</sup> <sub>above</sub> top of ground.

(4) casing PVC, 280'  
 (material) (depth)

— If telescope see back.  
 (size)

(5) screen 5' —  
 (length) (depth to top)

2", SCH. 80 PVC  
 (size) (material)

(6) pump 1/2 7  
 (HP) (yield gpm)

Elec.  
 (type power)

(7) electric log NO  
 (yes or no)  
N/A  
 (organization running log)

(8) how well bottom plugged BWU

description of formations encountered	from	to
Topsoil clay	0	14
Sand	14	36
Heavy clay	36	75
Clay - silt	75	97
sd - heavy gravel	97	117
clay - silt	117	165
sd fine	165	190
clay	190	220
sd	220	228
clay - silt	228	255
sd	255	285

CODED


REC-11  
 SEP 15 1974

MISS. BD. OF WATER COMM

DRILLERS REMARKS: N/A

If well telescopes please sketch and show depths.

GROUND LEVEL

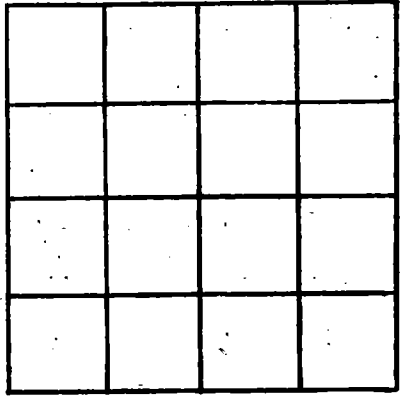

SECTION 13

Please indicate well location X.

ADDITIONAL INFORMATION

A series of horizontal lines for recording additional information, starting below the 'ADDITIONAL INFORMATION' header.

If more than one screen, show locations of each on sketch.