

HANCOCK
K 285
9-16-74

MISSISSIPPI
 BOARD OF WATER COMMISSIONERS
 416 North State Street
 Jackson, Mississippi 39201

CODED

WATER WELL DRILLERS LOG

Sept 16 1974 Woodwell Drilling Hancock
 date well completed firm name county well located

LANDOWNER:	description of formations encountered	from	to
<u>Clarence Schindler</u>	<u>Fill - Clay</u>	<u>0</u>	<u>17</u>
<u>Green meadow Rd</u>	<u>sd</u>	<u>17</u>	<u>35</u>
<u>Bay St. Louis, missi</u>	<u>clay</u>	<u>35</u>	<u>50</u>
(mailing address)	<u>clay & shell</u>	<u>50</u>	<u>82</u>
	<u>sd</u>	<u>82</u>	<u>98</u>
WELL LOCATION:	<u>clay - silt</u>	<u>98</u>	<u>196</u>
sec. <u>29</u> T. <u>8</u> N. R. <u>14</u> E	<u>fine sd</u>	<u>196</u>	<u>212</u>
<u>8</u> miles <u>west</u> of <u>B.S.L.</u>	<u>clay</u>	<u>212</u>	<u>226</u>
(distance) (direction) (nearest town)	<u>sd</u>	<u>226</u>	<u>245</u>
WELL PURPOSE: <u>Home</u>			
(home, irrigation, municipal, industrial)			
WELL COMPLETION DATA:			
(1) diameter (inches) <u>2"</u>			
(2) total depth (feet) <u>245</u>			
(3) static water level (feet) <u>2</u> <u>below</u> <u>above</u> top of ground.			
(4) casing <u>PVC</u> , <u>240</u> , (material) (depth)			
<u>-</u> If telescope see back. (size)			
(5) screen <u>5'</u> , <u>-240</u> (length) (depth to top)			
<u>2"</u> , <u>PVC</u> (size) (material)			
(6) pump <u>-</u> , <u>-</u> (HP) (yield gpm)			
<u>-</u> (type power)			
(7) electric log <u>NO</u> (yes or no)			
<u>N/A</u> (organization running log)			
(8) how well bottom plugged <u>BWW</u>			
DRILLERS REMARKS: <u>N/A</u>			


CODED

RECEIVED
OCT 17 1974

MISSISSIPPI BOARD OF WATER COMMISSIONERS

If well telescopes please sketch and show depths.

GROUND LEVEL

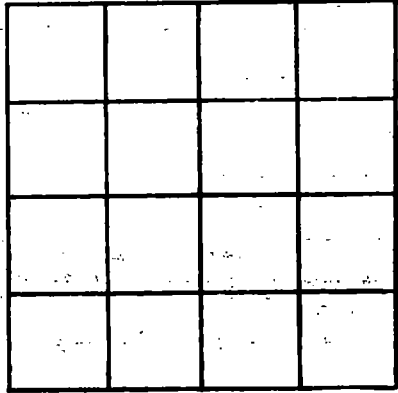

SECTION 29

Please indicate well location X.

ADDITIONAL INFORMATION

If more than one screen, show locations of each on sketch.