

HANCOCK
K 286
9-17-74

MISSISSIPPI
 BOARD OF WATER COMMISSIONERS
 416 North State Street
 Jackson, Mississippi 39201

INDEXED

WATER WELL DRILLERS LOG

Sept. 17 1974 Wood Well Drilling Hancock
 date well completed firm name county well located

LANDOWNER	description of formations encountered	from	to
<u>Manuel Fernandez</u>	<u>Fill Clay</u>	<u>0</u>	<u>15</u>
<u>Harbor Estates</u>	<u>Sd</u>	<u>15</u>	<u>35</u>
<u>Bay St. Louis, Miss.</u>	<u>Clay</u>	<u>35</u>	<u>52</u>
(mailing address)	<u>Clay - S Shell</u>	<u>52</u>	<u>84</u>
	<u>Sd</u>	<u>84</u>	<u>96</u>
	<u>Clay</u>	<u>96</u>	<u>108</u>
	<u>Sd & Red Hops</u>	<u>108</u>	<u>126</u>
	<u>Clay - Sd</u>	<u>126</u>	<u>194</u>
	<u>Sd</u>	<u>194</u>	<u>216</u>
	<u>Clay</u>	<u>216</u>	<u>225</u>
	<u>Sd</u>	<u>225</u>	<u>245</u>

WELL LOCATION:

sec. 29 T 8 N R 14 E
7 miles West of B.S.L.
 (distance) (direction) (nearest town)

WELL PURPOSE: Home
 (home, irrigation, municipal, industrial)

WELL COMPLETION DATA:

- (1) diameter (inches) 2
- (2) total depth (feet) 245
- (3) static water level (feet) 1 below top of ground. above
- (4) casing PVC, 240
 (material) (depth)
- If telescope see back.
 (size)
- (5) screen 5', -240
 (length) (depth to top)
- 2", PVC
 (size) (material)
- (6) pump ,
 (HP) (yield gpm)
- (type power)
- (7) electric log NO
 (yes or no)
- N/A
 (organization running log)
- (8) how well bottom plugged BWC

DRILLERS REMARKS: N/A


INDEXED

RECORDED
 OCT 17 1974

MISS. BD. OF WATER COMM

If well telescopes please sketch and show depths.

GROUND LEVEL

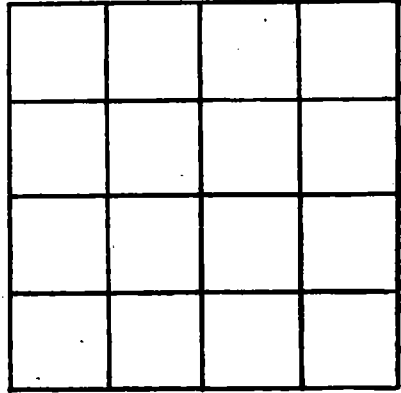

SECTION 29

Please indicate well location X.

ADDITIONAL INFORMATION

If more than one screen, show locations of each on sketch.