

**Hancock**  
**288**  
**10/11/74**

MISSISSIPPI  
 BOARD OF WATER COMMISSIONERS **CODED**  
 416 North State Street  
 Jackson, Mississippi 39201

**WATER WELL DRILLERS LOG**

10-11- 1974 ward Well Drilling Hancock  
 date well completed firm name county well located

LANDOWNER: Arien Boyle  
Hancock St.  
Bay St. Louis miss  
 (mailing address)

description of formations encountered	from	to
<u>Top Soil - clay</u>	<u>0</u>	<u>14</u>
<u>56 -</u>	<u>14</u>	<u>32</u>
<u>Grey Clay</u>	<u>32</u>	<u>80</u>
<u>Clay - Shell</u>	<u>80</u>	<u>107</u>
<u>Clay</u>	<u>107</u>	<u>141</u>
<u>Red Shell - SC</u>	<u>141</u>	<u>168</u>

WELL LOCATION:  
 sec. 5 T. 8 N. R. 14 E.  
10 miles W of B.S.L.  
 (distance) (direction) (nearest town)

WELL PURPOSE: Home  
 (home, irrigation, municipal, industrial)

- WELL COMPLETION DATA:
- (1) diameter (inches) 2
  - (2) total depth (feet) 168
  - (3) static water level (feet) 2 <sup>below</sup> above top of ground
  - (4) casing PVC, 163,  
 (material) (depth)  
 (size) If telescope see back.
  - (5) screen 5',  
 (length) (depth to top)  
2", SCH. 80 PVC  
 (size) (material)
  - (6) pump \_\_\_\_\_  
 (HP) (yield gpm)  
 (type power)
  - (7) electric log NO  
 (yes or no)  
N/A  
 (organization running log)
  - (8) how well bottom plugged BWU


**CODED**

**NOV 14 1974**  
 MISS. Bd. of WATER COMM

DRILLERS REMARKS: N/A

If well telescopes please sketch and show depths.

GROUND LEVEL

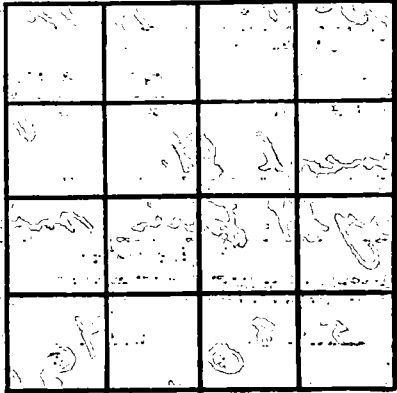

SECTION \_\_\_\_\_

Please indicate well location X.

ADDITIONAL INFORMATION

If more than one screen, show locations of each on sketch.