

HANCOCK
K 289
10-9-74

MISSISSIPPI
 BOARD OF WATER COMMISSIONERS
 416 North State Street
 Jackson, Mississippi 39201

WATER WELL DRILLERS LOG

10-9-74 date well completed Woodwell Drilling firm name Hancock county well located

LANDOWNER: Robert F. Kruse
Indian St.
Bay St. Louis, Miss
 (mailing address)

description of formations encountered	from	to
Top Soil - Clay	0	16
sd	16	35
dry clay	35	80
sd	80	96
Clay - Silt	96	137
sd. - Red Gravel	137	155

WELL LOCATION:
 sec. 33 T-8 N R-14 E
6 miles NW of B.S.L.
 (distance) (direction) (nearest town)

WELL PURPOSE: Domestic
 (home, irrigation, municipal, industrial)

WELL COMPLETION DATA:

(1) diameter (inches) 2"

(2) total depth (feet) 155'

(3) static water level (feet) 2 below above top of ground.

(4) casing PVC 150'
 (material) (depth)

- If telescope see back.
 (size)

(5) screen 5' -
 (length) (depth to top)

2" Stainless Steel
 (size) (material)

(6) pump 1/2 8
 (HP) (yield gpm)

Elc.
 (type power)

(7) electric log NO
 (yes or no)

N/A
 (organization running log)

(8) how well bottom plugged BWU

CODED

DRILLERS REMARKS: N/A


DISCONTINUED
RECORD

NOV 14 1974

MISS. BD. OF WATER COMMISSIONERS

If well telescopes please sketch and show depths.

GROUND LEVEL

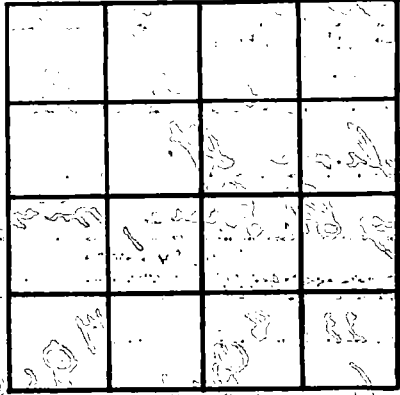

SECTION 33

Please indicate well location X.

ADDITIONAL INFORMATION

If more than one screen, show locations of each on sketch.