

HANCOCK
K 290
10-18-74

MISSISSIPPI
 BOARD OF WATER COMMISSIONERS CODED
 416 North State Street
 Jackson, Mississippi 39201

WATER WELL DRILLERS LOG

10-18-74 date well completed 1974 Ward Well Drilling firm name Hancock county well located

LANDOWNER: R.D. Little
Robin St.
Bay St. Louis miss'
 (mailing address)

description of formations encountered	from	to
Clay -	0	12
sd	12	45
Grey clay	45	80
sd	80	96
Silt-Blue clay	96	134
sd	134	154


WELL LOCATION:
 sec. 25 T. 8 N. R. 14 E.
8 miles N/W of B.S.L.
 (distance) (direction) (nearest town)

WELL PURPOSE: Home
 (home, irrigation, municipal, industrial)

CODED

- WELL COMPLETION DATA:
- (1) diameter (inches) 2"
 - (2) total depth (feet) 154
 - (3) static water level (feet) 2 ^(below) _{above} top of ground.
 - (4) casing PVC, 149,
 (material) (depth)
 (size) If telescope see back.
 - (5) screen 5', -
 (length) (depth to top)
2", PVC
 (size) (material)
 - (6) pump -, -
 (HP) (yield gpm)
 (type power)
 - (7) electric log NO
 (yes or no)
N/A
 (organization running log)
 - (8) how well bottom plugged BWU

DRILLERS REMARKS: N/A

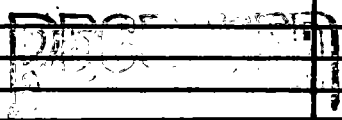

NOV 22 1974

If well telescopes please sketch and show depths.

GROUND LEVEL

SECTION 28

Please indicate well location X.

ADDITIONAL INFORMATION

If more than one screen, show locations of each on sketch.