

HANCOCK
K291
10-25-74

MISSISSIPPI
 BOARD OF WATER COMMISSIONERS
 416 North State Street
 Jackson, Mississippi 39201

CODED

WATER WELL DRILLERS LOG

10-25 1974 Woodwell Drilling Hancock
 date well completed firm name county well located

LANDOWNER: John Glasson
Rt. 3, Box 358
Bay St. Louis, Miss.
 (mailing address)

description of formations encountered	from	to
<u>Sandy clay</u>	<u>0</u>	<u>16</u>
<u>sd</u>	<u>16</u>	<u>56</u>
<u>dry clay - shell</u>	<u>56</u>	<u>97</u>
<u>sd</u>	<u>97</u>	<u>120</u>

WELL LOCATION:
 sec. 33 T. 8 N. R. 14 E.
5 miles W of B.S.L.
 (distance) (direction) (nearest town)

WELL PURPOSE: Home
 (home, irrigation, municipal, industrial)

- WELL COMPLETION DATA:
- (1) diameter (inches) 2
 - (2) total depth (feet) 120'
 - (3) static water level (feet) 5 ^{below}/_{above} top of ground
 - (4) casing PVC, 115'
 (material) (depth)
 (size) If telescope see back.
 - (5) screen 5', -
 (length) (depth to top)
2", PVC
 (size) (material)
 - (6) pump -, -
 (HP) (yield gpm)
 (type power)
 - (7) electric log no
 (yes or no)
N/A
 (organization running log)
 - (8) how well bottom plugged BWV


CODED

NOV 22 1974

DRILLERS REMARKS: N/A

If well telescopes please sketch and show depths.

GROUND LEVEL

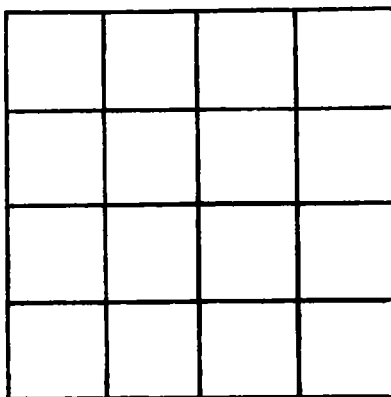

SECTION 33

Please indicate well location X.

ADDITIONAL INFORMATION

If more than one screen, show locations of each on sketch.