

**HANCOCK**  
**K 292**  
**7-23-74**

MISSISSIPPI  
 BOARD OF WATER COMMISSIONERS  
 416 North State Street  
 Jackson, Mississippi 39201

**CODED**

**WATER WELL DRILLERS LOG**

July 23 19 74 Sutter Well Works Hancock  
 date well completed firm name county well located

LANDOWNER: R. G. Flashner

4400 Washington Avenue

New Orleans, La. 70125  
 (mailing address)

WELL LOCATION:

sec. 26 T. 8 S. R. 14 W.  
 $\frac{1}{2}$  miles W of Bay St Louis  
 (distance) (direction) (nearest town)

WELL PURPOSE: home  
 (home, irrigation, municipal, industrial)

WELL COMPLETION DATA:

- (1) diameter (inches) 2"
- (2) total depth (feet) 427'
- (3) static water level (feet) 1' ~~static~~ above top of ground.
- (4) casing galv. 420'  
 (material) (depth)  
2" If telescope see back.  
 (size)
- (5) screen 7' 420'  
 (length) (depth to top)  
2" stainless steel  
 (size) (material)
- (6) pump 1/2 15  
 (HP) (yield gpm)  
elec.  
 (type power)
- (7) electric log no  
 (yes or no)  
 (organization running log)
- (8) how well bottom plugged B.P. Valve


description of formations encountered

from

to

Clay & sand	0	10
Gravel	10	148
Clay	148	251
Sand	251	294
Clay	294	400
Sand	400	433

DRILLERS REMARKS:

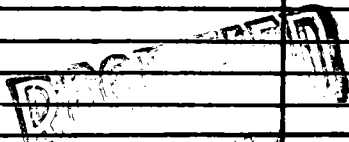

OCT 21 1974

MISS. BD. OF WATER COMM

