

HANCOCK
K294
7/18/74

MISSISSIPPI
BOARD OF WATER COMMISSIONERS
 416 North State Street
 Jackson, Mississippi 39201
WATER WELL DRILLERS LOG

CODED

7-18-74 19 _____ Sutter Well Works _____ Hancock
 date well completed firm name county well located

LANDOWNER: A. J. Cegali
7512 Morrison Road
New Orleans, La. 70126
 (mailing address)

description of formations encountered	from	to
	Clay	0
Sand & gravel	3	75
Clay	75	171

WELL LOCATION:
 sec. 26 T. 8 N. R. 14 E.
 S. Bay
1 miles W of St. Louis
 (distance) (direction) (nearest town)

Sand	171	193
Clay	193	405
Sand	405	443

WELL PURPOSE: home
 (home, irrigation, municipal, industrial)

WELL COMPLETION DATA:

- (1) diameter (inches) 2"
- (2) total depth (feet) 443'
- (3) static water level (feet) 2' ~~below~~ above top of ground.
- (4) casing galv. 433'
 (material) (depth)
2"
 (size) if telescope see back.
- (5) screen 10' 433'
 (length) (depth to top)
2" stainless steel
 (size) (material)
- (6) pump 1/2 15
 (HP) (yield gpm)
elec.
 (type power)
- (7) electric log no
 (yes or no)

 (organization running log)
- (8) how well bottom plugged B.P. Valve


DRILLERS REMARKS: _____

RECEIVED

SEP 29 1974

If well telescopes please sketch and show depths.

GROUND LEVEL

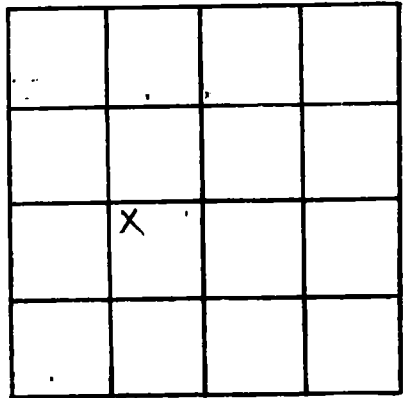

SECTION _____

Please indicate well location X.

ADDITIONAL INFORMATION

If more than one screen, show locations of each on sketch.