

CODED

HANCOCK
K 296
9/25/74

MISSISSIPPI
BOARD OF WATER COMMISSIONERS
416 North State Street
Jackson, Mississippi 39201

CODED

WATER WELL DRILLERS LOG

Sept. 25 1974 Wood well Dr. Hancock
date well completed firm name county well located

LANDOWNER: Joseph Cardinal
 Hwy 603
 Bay St. Louis Miss
(mailing address)

description of formations encountered	from	to
<u>Fine Clay</u>	<u>0</u>	<u>16</u>
<u>SD</u>	<u>16</u>	<u>45</u>
<u>Clay</u>	<u>45</u>	<u>96</u>
<u>FINE Bd.</u>	<u>96</u>	<u>112</u>
<u>BLUE CLAY</u>	<u>112</u>	<u>142</u>
<u>SD</u>	<u>142</u>	<u>161</u>

WELL LOCATION:
sec. 40 T. 8 N. R. 14 E
7 miles N/W of B.S.L.
(distance) (direction) (nearest town)

WELL PURPOSE: Home
(home, irrigation, municipal, industrial)

- WELL COMPLETION DATA:
- (1) diameter (inches) 2
 - (2) total depth (feet) 161 feet
 - (3) static water level (feet) 3 ^{below} top of ground
 - (4) casing PVC, 156'
(material) (depth)
If telescope see back.
(size)
 - (5) screen 5' -
(length) (depth to top)
2" PVC
(size) (material)
 - (6) pump - -
(HP) (yield gpm)
elec.
(type power)
 - (7) electric log no
(yes or no)
N/A
(organization running log)
 - (8) how well bottom plugged B.M.V.

DRILLERS REMARKS: N/A


RECEIVED

OCT 31 1974

MISS. BD. OF WATER COMMISSIONERS

If well telescopes please sketch and show depths.

GROUND LEVEL

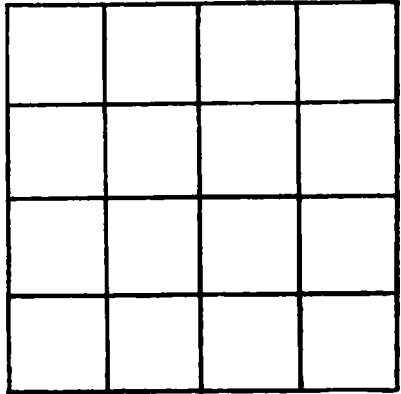

SECTION 40

Please indicate well location X.

ADDITIONAL INFORMATION

If more than one screen,
show locations of each on sketch.