

HANCOLK
K 297
9/27/74

MISSISSIPPI
 BOARD OF WATER COMMISSIONERS CODE
 416 North State Street
 Jackson, Mississippi 39201

WATER WELL DRILLERS LOG

Sept. 27 1974 Ward Well Drilling Hancock
 date well completed firm name county well located

LANDOWNER: Angelo Juarros
Rt. 1, Box 450
Bay St. Louis, Miss.
 (mailing address)

description of formations encountered	from	to
<u>fill-clay</u>	<u>0</u>	<u>14</u>
<u>SC</u>	<u>14</u>	<u>43</u>
<u>clay</u>	<u>43</u>	<u>94</u>
<u>sd-fine</u>	<u>94</u>	<u>176</u>
<u>blue clay</u>	<u>116</u>	<u>144</u>
<u>SC</u>	<u>144</u>	<u>163</u>

WELL LOCATION:
 sec. 40 T. 8 N. R. 14 E.
6 miles N/W of B.S.L.
 (distance) (direction) (nearest town)

WELL PURPOSE: Home
 (home, irrigation, municipal, industrial)

- WELL COMPLETION DATA:
- (1) diameter (inches) 2"
 - (2) total depth (feet) 163
 - (3) static water level (feet) 4 ^{below} _{above} top of ground.
 - (4) casing PVC, 158.
 (material) (depth)
 — If telescope see back.
 (size)
 - (5) screen 5', —
 (length) (depth to top)
2", PVC
 (size) (material)
 - (6) pump 1/2, 7
 (HP) (yield gpm)
Elec
 (type power)
 - (7) electric log NO
 (yes or no)
N/A
 (organization running log)
 - (8) how well bottom plugged BWU


RECEIVED
 RECEIVED
 OCT 21 1974

DRILLERS REMARKS: N/A

MISS. BD. OF WATER COMM

If well telescopes please sketch and show depths.

GROUND LEVEL

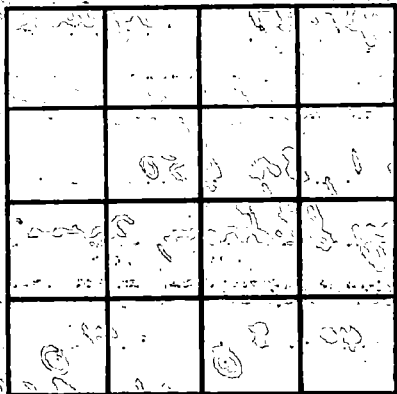

SECTION 40

Please indicate well location X.

ADDITIONAL INFORMATION

A series of horizontal lines for recording additional information, with some faint handwritten notes and numbers scattered across the lines.

If more than one screen, show locations of each on sketch.