

HANCOCK
K300
11-13-74

MISSISSIPPI
BOARD OF WATER COMMISSIONERS
416 North State Street
Jackson, Mississippi 39201

WATER WELL DRILLERS LOG

11-13-74 date well completed
Ward Well Drilling firm name
Hancock county well located

LANDOWNER	description of formations encountered	from	to
Hayward Lambert Deer St. - Garden Island	Fill - clay	0	18
Bay St. Louis miss (mailing address)	sd clay - silt sd	18 42 234	42 234 264

WELL LOCATION:
sec. 22 T-8 N R-14 E
4 miles N/W of B.S.L.
(distance) (direction) (nearest town)

WELL PURPOSE: Home
(home, irrigation, municipal, industrial)

- WELL COMPLETION DATA:
- (1) diameter (inches) 2"
 - (2) total depth (feet) 264 ft.
 - (3) static water level (feet) 3 below top of ground.
 - (4) casing PVC, 254 (material) (depth)
If telescope see back. (size)
 - (5) screen 10' (length) (depth to top)
2" SCH. 80 - PVC (size) (material)
 - (6) pump 1 (HP) 10 (yield gpm)
Elec. (type power)
 - (7) electric log NO (yes or no)
N/A (organization running log)
 - (8) how well bottom plugged BWV

CODED


RECORDED

DEC 17 1974

DRILLERS REMARKS: N/A

If well telescopes please sketch and show depths.

GROUND LEVEL

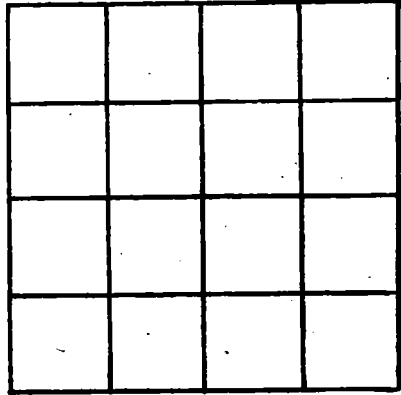

SECTION 27

Please indicate well location X.

ADDITIONAL INFORMATION

If more than one screen, show locations of each on sketch.