

**HANCOCK**  
~~Harrison~~  
**K303**  
**12-2-74**

MISSISSIPPI  
 BOARD OF WATER COMMISSIONERS  
 416 North State Street  
 Jackson, Mississippi 39201

CODED

WATER WELL DRILLERS LOG

**Hancock**  
~~Harrison~~

Dec. 2 1974 Sutter Well Works  
 date well completed firm name county well located

LANDOWNER: Dickson Realty

Waveland, Miss.

(mailing address)

WELL LOCATION:

sec 21 T 8 S R 14 W  
3 miles NW of Bay St Louis  
 (distance) (direction) (nearest town)

WELL PURPOSE: home  
 (home, irrigation, municipal, industrial)

CODED

WELL COMPLETION DATA:

- (1) diameter (inches) 2"
- (2) total depth (feet) 153'
- (3) static water level (feet) 1' below top of ground
- (4) casing galv. 148'  
 (material) (depth)  
2" if telescope see back.  
 (size)
- (5) screen 5' 148'  
 (length) (depth to top)  
2" stainless steel  
 (size) (material)
- (6) pump owner's  
 (HP) (yield gpm)  
elec.  
 (type power)
- (7) electric log no  
 (yes or no)  
 (organization running log)
- (8) how well bottom plugged B.P. Valve


description of formations encountered

from

to

Clay	0	19
Sand	19	53
Clay	53	110
Sand	110	153

DRILLERS REMARKS:

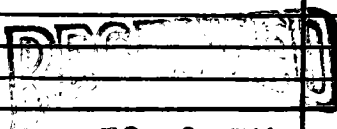

DEC 23 1974

MISS. BD. OF WATER COMM.

If well telescopes please sketch and show depths.

GROUND LEVEL


SECTION \_\_\_\_\_

Please indicate well location X.

ADDITIONAL INFORMATION

If more than one screen, show locations of each on sketch.